



FALL CREEK REGIONAL WASTE DISTRICT

Box 44, Pendleton, Indiana 46064

4:30-4:45

2-0008080.00

Nº 001379

APPLICATION FOR SEWER PERMIT

Permit No. _____ Date 3-7-86
Permit Void 90 days from Date of Issuance
Owner Name Beecher Jones
Property Address 633 ERNIE LU
Lot # _____ P.O. Box _____
Town ANDERSON, IN Zip Code 46013
Phone 644-0703 Water Meter _____
\$ 150.00 Tap on Fee Paid
\$ 25.00 Inspection fee paid

Application is hereby made for connection to the Fall Creek Regional Waste District Sewer System for the above listed property - Permit Type: Residential ☒, Commercial _____, Industrial _____, or Governmental/Institutional _____. User Information _____.

All workmanship and materials shall conform to the standards of the District Ordinance as described in Ordinance 84-2 and 84-3 as amended. Acceptance and approval must be made by the District inspector or his duly authorized representative before backfilling and final connection is made to the main sewer lines. Any violation of applicable regulations will cause all lines and appurtenances in violation to be removed and replaced at the owners expense.

The Fall Creek Regional Waste District is responsible for the inspection, approval of materials, and installation techniques only. All costs for materials and installation and any liabilities resulting from same is the sole responsibility of the property owner.

I have read and fully understand the above provisions and agree to comply by said provisions.

Beecher R Jones
APPLICANT(S) SIGNATURE

INSPECTOR B

Date inspected 5-21-86 Approved ☒ Rejected _____

Reason for rejection _____

Date reinspected _____ Approved _____ Rejected _____

Notes:

Size Pipe 6"

Type Pipe PVC

Basement Yes _____ No ☒


Sump Pump Yes _____ No ☒

Downspout to Ground Yes ☒ No _____

Septic Tank Pumped & filled Yes _____ No ☒

Contractor Derry Moore

Special Conditions _____

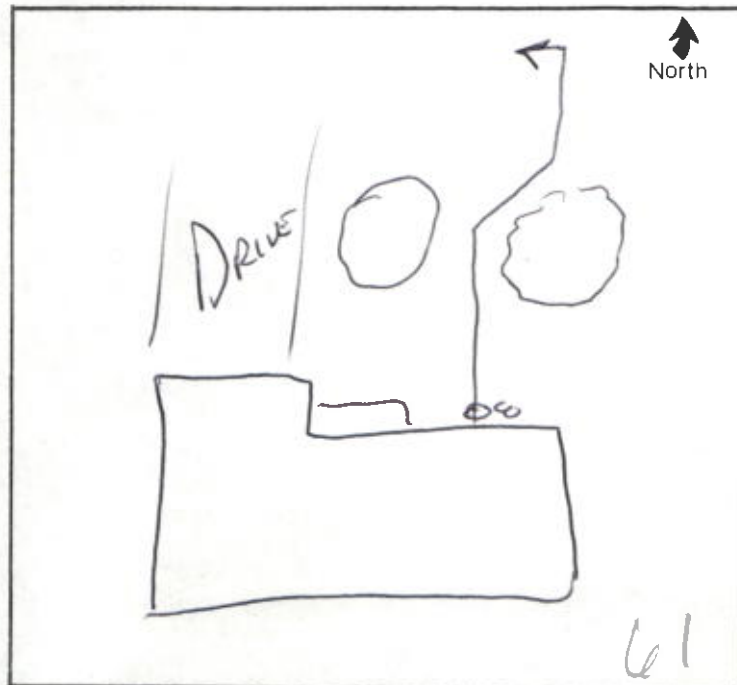

SALT CREEK REGIONAL WASTE DISTRICT

2000 E. 10th Street, Suite 100, Salt Lake City, UT 84143



20010012

Project Name
Salt Creek

4/1/00

Project No.
44-000

1000
1000

Project Description: The project is to construct a new waste water treatment plant. The plant will be located on the site of the old plant. The new plant will have a capacity of 100,000 gallons per day. The project will include the construction of the plant building, the installation of the equipment, and the construction of the access roads. The project will also include the construction of the sewer lines and the installation of the sewer pumps. The project will be completed by the end of the year.

Project Location: The project is located on the site of the old plant. The site is located on the corner of 10th Street and 100th Avenue. The site is approximately 100,000 square feet in size. The site is currently vacant.

Project Status: The project is currently in the planning stage. The project will be completed by the end of the year.

Project Manager
John Doe

3

2-5-00



Project Description: The project is to construct a new waste water treatment plant. The plant will be located on the site of the old plant. The new plant will have a capacity of 100,000 gallons per day. The project will include the construction of the plant building, the installation of the equipment, and the construction of the access roads. The project will also include the construction of the sewer lines and the installation of the sewer pumps. The project will be completed by the end of the year.