



FALL CREEK REGIONAL WASTE DISTRICT

9378 S. 650 West PO Box 59  
Pendleton, IN 46064-0059 778-7544

22-27585-00

APPLICATION FOR SEWER PERMIT

Nº 2668

Date 2-22-99

Permit Void 90 days from Date of Issuance

Owner Name Charles & Cheryl Baker

Property Address 6348 S. Pleasant Court

Lot # 138 P.O. Box

Town Pendleton, IN Zip Code 46064

Phone City Water Well ☒

\$ 400.00 Tap on Fee Paid

\$ Inspection fee paid

Application is hereby made for connection to the Fall Creek Regional Waste District Sewer System for the above listed property - Permit Type: Residential ☒, Commercial, Industrial, or Governmental/Institutional. User Information

All workmanship and materials shall conform to the standards of the District Ordinance as described in Ordinance 84-2 and 84-3 as amended. Acceptance and approval must be made by the District inspector or his duly authorized representative before backfilling and final connection is made to the main sewer lines. Any violation of applicable regulations will cause all lines and appurtenances in violation to be removed and replaced at the owners expense.

The Fall Creek Regional Waste District is responsible for the inspection, approval of materials, and installation techniques only. All costs for materials and installation and any liabilities resulting from same is the sole responsibility of the property owner.

I have read and fully understand the above provisions and agree to comply by said provisions.

Harold E. Riffey  
APPLICANT(S) SIGNATURE

INSPECTOR Don/Ber


Date inspected 3-3-99 Approved Rejected

Reason for rejection

Date reinspected Approved Rejected

Notes:  
Size Pipe 6"  
Type Pipe PVC 35"  
Basement Yes No ☒  
Sump Pump Yes No ☒  
Downspout to Ground Yes ☒ No  
Septic Tank Pumped & filled Yes ☒ No  
Contractor Bolton Exc.  
Special Conditions

Existing Home  
New Construction ☒

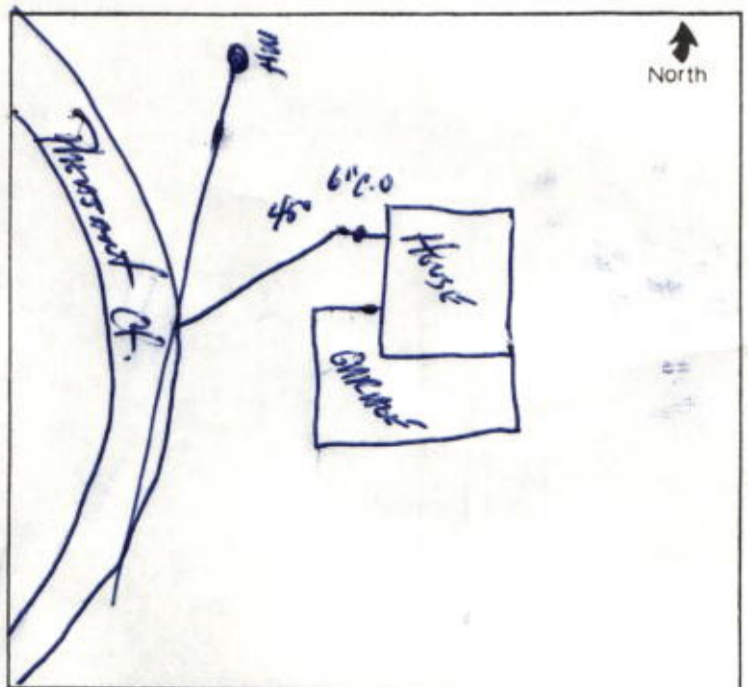

$\frac{1}{2}$

PP-5-2

John Eric