

## FALL CREEK REGIONAL WASTE DISTRICT

No 5249

9378 S 650 WEST, P.O. BOX 59, PENDLETON, IN 46064

765-778-7544

## AGREEMENT FOR SANITARY SEWER SERVICE

This Agreement made and entered into this 17<sup>th</sup> day of June, 2004, between FALL CREEK REGIONAL WASTE DISTRICT ("District") and Bob Taylor ("Applicant") regarding the provision of sanitary sewer service, and the assignment of capacity in, and connection to, the District's facilities for the premises located at lot 142, Fiddlers Green 6357 S Cabriolet

NOW THEREFORE, the parties, in consideration of the mutual promises set out in this Agreement, the receipt and sufficiency of which is hereby acknowledged, agree as follows:

1. The Applicant agrees that all workmanship and materials shall conform to all District ordinances and the District's construction standards. District must accept and approve all work and materials before backfilling and final connection is made to the sewer mains. Any violation of this provision will cause all lines and appurtenances in violation to be removed and replaced at the Applicant's expense.
2. The District shall have the right to enter upon the Applicant's premises at all reasonable times to inspect, repair, or replace any equipment used in connection with the District's service or which has an impact on said service.
3. The Applicant shall be responsible for all monthly user rates, capacity charges, and tap fees. The failure to pay any rate charge or fee may result in a lien against the property and/or the termination of service to the property, the cost of which will be borne by Applicant, including, but not limited to, all attorney's fees and collection costs.
4. The District shall not be responsible for any damages as a result of any failure to supply service unless said damages are due to default, neglect or culpability on the part of the District.
5. If there is an available sanitary sewer within three hundred (300) feet of the property line, the property owner shall be required to connect to the District's sanitary sewer system.
6. The Applicant and District agree that the provision of sanitary sewer service touches and concerns the property and the terms of this Agreement bind the District and Applicant and their heirs, executors, administrators, personal representatives, successors, agents, attorneys, assigns, designees, and transferees.

The parties hereto have read and fully understand the above provisions and agree to comply with said provisions.

FALL CREEK REGIONAL WASTE DISTRICT  
William Wilson  
Signature

APPLICANT  
Cindy Costumero  
Signature

STATE OF INDIANA )  
 ) SS:  
COUNTY OF MADISON )

SUBSCRIBED and sworn to before me this 17<sup>th</sup> day of June, 2004.

My Commission Expires:  
2-20-2008

Signature Deborah L. Wilson  
Printed Deborah L Wilson  
Notary Public  
Resident of Madison County

\*\*\*\*\*  
INSPECTOR TK DATE INSPECTED 7/14/04 APPROVED ✓ REJECTED \_\_\_\_\_

REASON FOR REJECTION \_\_\_\_\_

DATE REINSPECTED \_\_\_\_\_ APPROVED \_\_\_\_\_ REJECTED \_\_\_\_\_

NOTES:  
SIZE PIPE 6" TYPE PIPE SDR 35

BASEMENT YES NO

SUMP PUMP YES NO

DOWNSPOUT TO GROUND YES NO


SEPTIC TANK PUMPED & FILLED YES NO

CONTRACTOR ROBERT TAYLOR INC.

SPECIAL CONDITIONS \_\_\_\_\_

EXISTING HOME \_\_\_\_\_

NEW CONSTRUCTION X

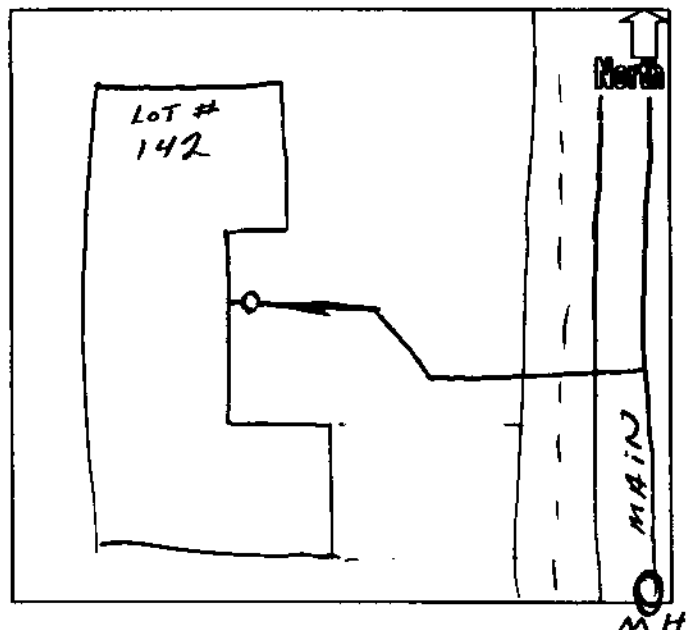



ROBERT G. TAYLOR, INC.  
8880 SOUTH CR. 800 WEST  
DALEVILLE, IN 47334

FIRST MERCHANTS BANK, N.A.  
MUNCIE, INDIANA  
71-65749

2107

00002107

PAY TWO THOUSAND SIX HUNDRED THIRTY-FIVE AND XX / 100 Dollars AMOUNT

06/17/04 \*\*\*\*\*\$2,635.00

TO THE ORDER OF Fall Creek Regional Waste Dist  
P.O. Box 59  
Pendleton, IN 46064

ROBERT G. TAYLOR, INC.

*Cindy L. Cotton*  
AUTHORIZED SIGNATURE

⑈002107⑈ ⑆074900657⑆