


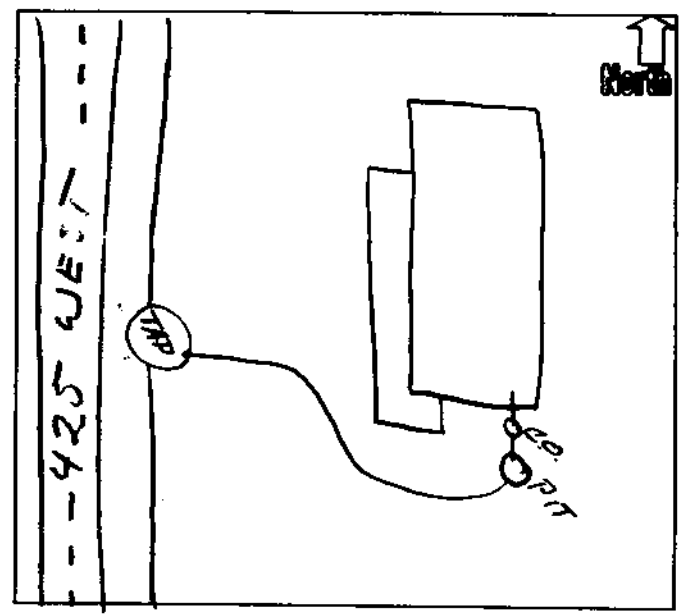

CHRISTINE L OBRAS 11/95
WILLIAM A OBRAS PH (765) 778-7817
6360 S 425 W,
PENDLETON, IN 46064-9547

3568

7-23-04

71-167749
BRANCH 101

DATE

PAY TO THE
ORDER OF

F C R W D

\$ 475.00

Four Hundred Seventy Five and ^{xx}/₁₀₀ DOLLARS



Security
Features
Details on
Back



FOR

Tap fee

Christine L Obras

⑆07490672⑆

WILLIAM A OBRAS OR 02-98
CHRISTINE L OBRAS
331 S PENDLETON AVE, PH(765)778-7617
PENDLETON, IN 46064

664

71-167749
BRANCH 10006

July 2 ~~19~~ 2004

PAY TO THE
ORDER OF

FCRWD

\$ 1,549.72

one-thousand five-hundred forty-nine and $\frac{72}{100}$ DOLLARS



"Hoosier Owned & Hoosier Proud"

FOR Grinder Unit

William A Obras

⑆074901672⑆