




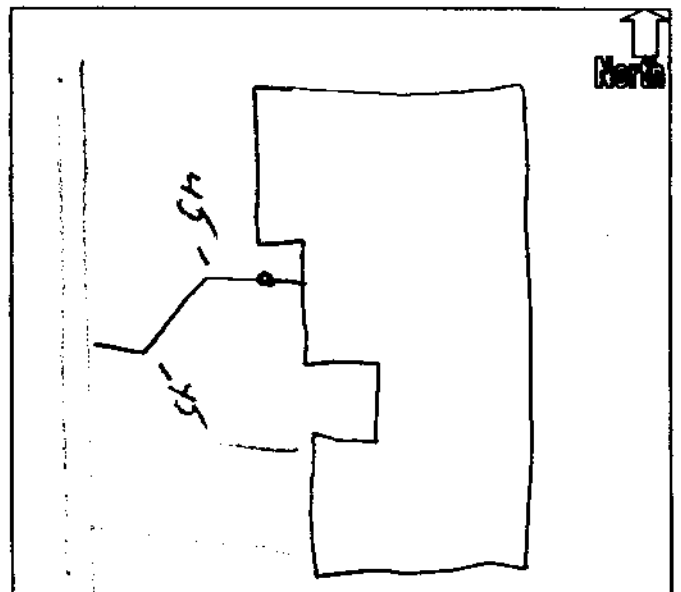

PRICE BUILDERS, INC.
4027 COLUMBUS AVE.
ANDERSON, IN 46013

14184

Fall Creek Regional Waste District

DATE 12/17/04

71-553/749

PAY
TO THE
ORDER OF

Two thousand Six hundred Twenty Five and 00/100

\$ *2635.00*

DOLLARS



Madison
Community Bank

FOR

Sam R. Price

⑈014184⑈ ⑈074905539⑈