


Carrick Glen Lot # 181

Wills Ex.

6/11/24

N ←

636 Blackrock Dr.

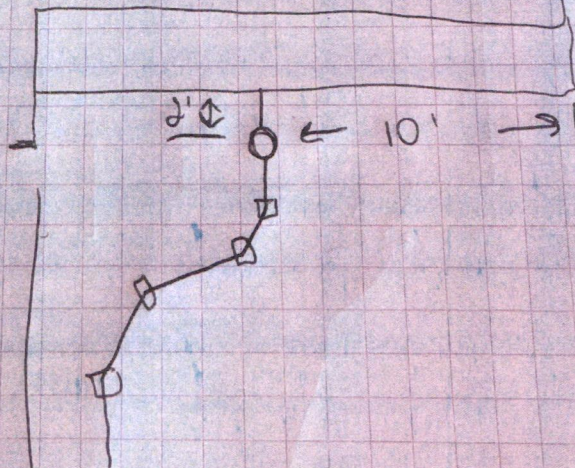



P. R. HORTON DRH
America's Builder

JP Morgan Chase Bank, N.A.
Syracuse, NY

Check Number 1475064

DRH Inc. Controlled Disb
1341 Horton Circle
Arlington, TX 76011

50-937
213
2720128

Date	Amount
03/23/22	\$*****760.00
Void after 6 months from date of issue	

SEVEN HUNDRED SIXTY AND 00/100 *****

Pay To The Order Of:
FALL CREEK REGIONAL WASTE DISTRICT
9378 SOUTH 650 WEST
PENDLETON IN 46064

D. L. Horton

CG 181

012189