

Gidw.


PROJECT Phase II SHEET _____ OF _____

SUBJECT _____ DATE 5-8-18

JOB NO. 4447

BY Atlas

636 S. Broadway

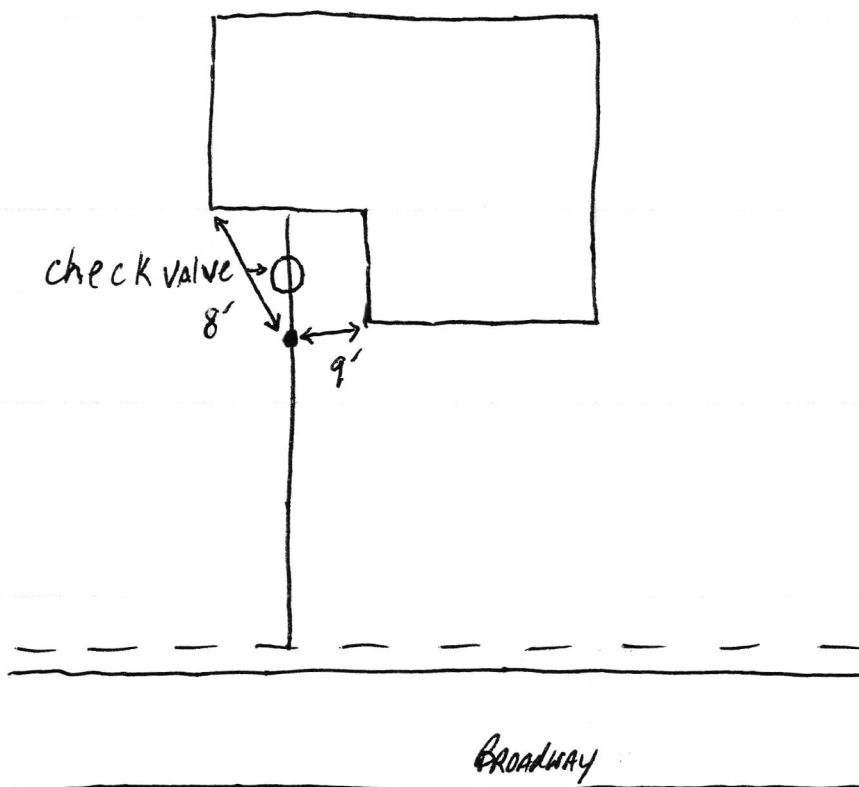

134 S Broadway

Sgt Phase II

5.14.18

