


Gidw.

PROJECT Phase II SHEET _____ OF _____
SUBJECT _____ DATE 6- -18
JOB NO 4447
BY Atlas

637 S. Silver

← N

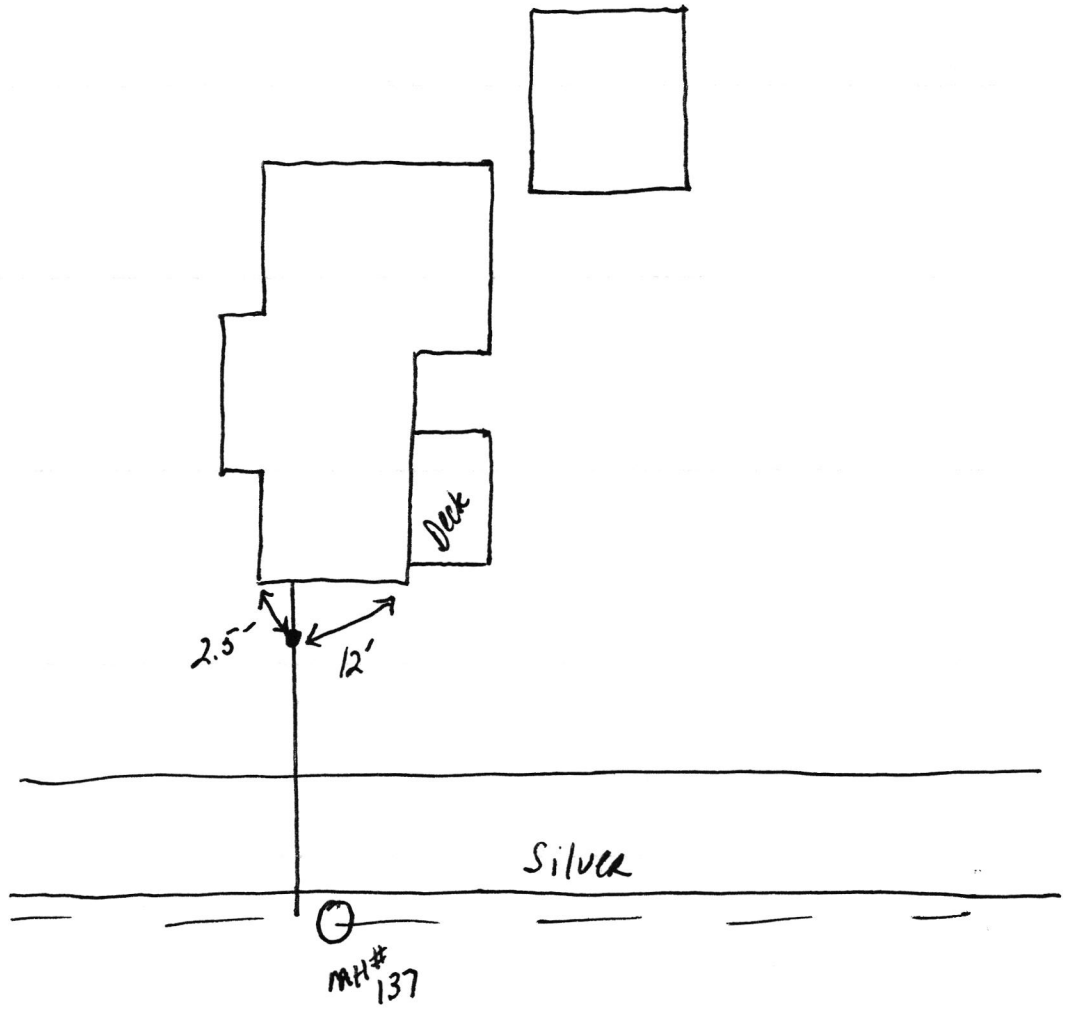

631 Silver

SRF Phase II

6.21.18

