

26-10020.00
4588

FALL CREEK REGIONAL WASTE DISTRICT

9378 S 650 WEST, P.O. BOX 59, PENDLETON, IN 46064

765-778-7544

AGREEMENT FOR SANITARY SEWER SERVICE

This Agreement made and entered into this 3rd day of June, 2002, between FALL CREEK REGIONAL WASTE DISTRICT ("District") and Michael Wright ("Applicant") regarding the provision of sanitary sewer service, and the assignment of capacity in, and connection to, the District's facilities for the premises located at 6395 Fox Run Chase lot 3

NOW THEREFORE, the parties, in consideration of the mutual promises set out in this Agreement, the receipt and sufficiency of which is hereby acknowledged, agree as follows:

1. The Applicant agrees that all workmanship and materials shall conform to all District ordinances and the District's construction standards. District must accept and approve all work and materials before backfilling and final connection is made to the sewer mains. Any violation of this provision will cause all lines and appurtenances in violation to be removed and replaced at the Applicant's expense.
2. The District shall have the right to enter upon the Applicant's premises at all reasonable times to inspect, repair, or replace any equipment used in connection with the District's service or which has an impact on said service.
3. The Applicant shall be responsible for all monthly user rates, capacity charges, and tap fees. The failure to pay any rate charge or fee may result in a lien against the property and/or the termination of service to the property, the cost of which will be borne by Applicant, including, but not limited to, all attorney's fees and collection costs.
4. The District shall not be responsible for any damages as a result of any failure to supply service unless said damages are due to default, neglect or culpability on the part of the District.
5. If there is an available sanitary sewer within three hundred (300) feet of the property line, the property owner shall be required to connect to the District's sanitary sewer system.
6. The Applicant and District agree that the provision of sanitary sewer service touches and concerns the property and the terms of this Agreement bind the District and Applicant and their heirs, executors, administrators, personal representatives, successors, agents, attorneys, assigns, designees, and transferees.

The parties hereto have read and fully understand the above provisions and agree to comply with said provisions.

FALL CREEK REGIONAL WASTE DISTRICT

APPLICANT

Signature

Signature

STATE OF INDIANA)
) SS:
COUNTY OF MADISON)

SUBSCRIBED and sworn to before me this _____ day of _____, 200__.

My Commission Expires:

Signature

Printed

Notary Public
Resident of Madison County

INSPECTOR 3 DATE INSPECTED 6-4-02 APPROVED / REJECTED _____

REASON FOR REJECTION PARTIAL 4" & Pit only

DATE REINSPECTED _____ APPROVED _____ REJECTED _____

NOTES:

SIZE PIPE 4" TYPE PIPE PVC

BASEMENT YES X NO _____

SUMP PUMP YES X NO _____

DOWNSPOUT TO GROUND YES X NO _____


SEPTIC TANK PUMPED & FILLED YES _____ NO X

CONTRACTOR BBRYs

SPECIAL CONDITIONS _____

EXISTING HOME _____

NEW CONSTRUCTION X

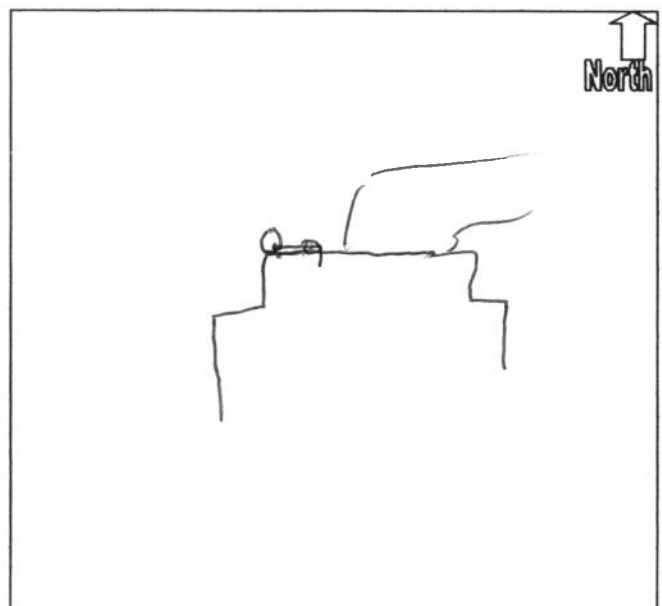



GERRY'S CONSTRUCTION SERVICE

TIN#35-2048835
4424 E. 575 S.
MARKLEVILLE, IN 46056
(765) 779-4269

6443

71-553/749
BRANCH 2

PAY
TO THE
ORDER OF

FLRW

DATE

\$ 1024 ⁸⁰/₁₀₀

One Thousand Twenty Four

⁸⁰/₁₀₀

DOLLARS



Security
Features
Details on
Back.




Madison
Community Bank

FOR

GRINDER PIT for Fox Run

[Signature]

⑈006443⑈ ⑆074905539⑆ 894 009 8⑈

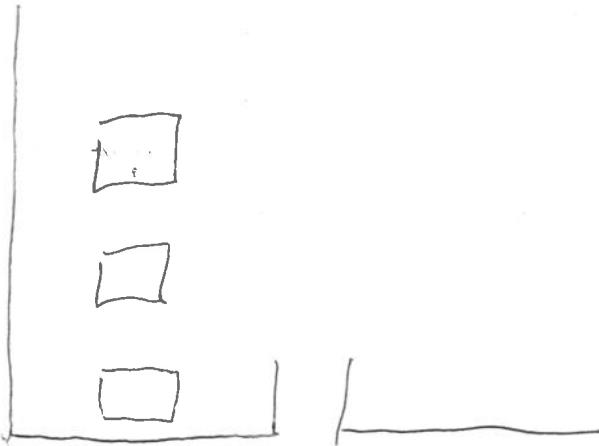



GERRY'S CONSTRUCTION SERVICE

TIN#35-2048835
4424 E. 575 S.
MARKLEVILLE, IN 46056
(765) 779-4269

6470

71-553/749
BRANCH 2

6-21-02

DATE 00

PAY
TO THE
ORDER OF

\$ 950

DOLLARS



Security
Features
Details on
Back



Madison
Community Bank

FOR

Key Fredrick

⑈006470⑈ ⑆074905539⑆ 894 009 6⑈

*tap fee for 6395 Fox Chase &
6433 Fox Chase*

