

22-39935.00
4603

FALL CREEK REGIONAL WASTE DISTRICT
9378 S 650 WEST, P.O. BOX 59, PENDLETON, IN 46064
765-778-7544

AGREEMENT FOR SANITARY SEWER SERVICE

This Agreement made and entered into this 28th day of June, 2002, between FALL CREEK REGIONAL WASTE DISTRICT ("District") and Robert H. Taylor ("Applicant") regarding the provision of sanitary sewer service, and the assignment of capacity in, and connection to, the District's facilities for the premises located at Lot #114 Juddlers Green 6398 S Cabriolet Way

NOW THEREFORE, the parties, in consideration of the mutual promises set out in this Agreement, the receipt and sufficiency of which is hereby acknowledged, agree as follows:

1. The Applicant agrees that all workmanship and materials shall conform to all District ordinances and the District's construction standards. District must accept and approve all work and materials before backfilling and final connection is made to the sewer mains. Any violation of this provision will cause all lines and appurtenances in violation to be removed and replaced at the Applicant's expense.
2. The District shall have the right to enter upon the Applicant's premises at all reasonable times to inspect, repair, or replace any equipment used in connection with the District's service or which has an impact on said service.
3. The Applicant shall be responsible for all monthly user rates, capacity charges, and tap fees. The failure to pay any rate charge or fee may result in a lien against the property and/or the termination of service to the property, the cost of which will be borne by Applicant, including, but not limited to, all attorney's fees and collection costs.
4. The District shall not be responsible for any damages as a result of any failure to supply service unless said damages are due to default, neglect or culpability on the part of the District.
5. If there is an available sanitary sewer within three hundred (300) feet of the property line, the property owner shall be required to connect to the District's sanitary sewer system.
6. The Applicant and District agree that the provision of sanitary sewer service touches and concerns the property and the terms of this Agreement bind the District and Applicant and their heirs, executors, administrators, personal representatives, successors, agents, attorneys, assigns, designees, and transferees.

The parties hereto have read and fully understand the above provisions and agree to comply with said provisions.

FALL CREEK REGIONAL WASTE DISTRICT
Jan Carey
Signature
STATE OF INDIANA)
) SS:
COUNTY OF MADISON)

APPLICANT

Signature

SUBSCRIBED and sworn to before me this _____ day of _____, 200____.

My Commission Expires: _____ Signature _____
Printed _____

Notary Public
Resident of Madison County

INSPECTOR Be DATE INSPECTED 8-29-02 APPROVED _____ REJECTED _____

REASON FOR REJECTION _____

DATE REINSPECTED _____ APPROVED _____ REJECTED _____

NOTES:
SIZE PIPE 6 TYPE PIPE PVC

BASEMENT YES NO X

SUMP PUMP YES NO X

DOWNSPOUT TO GROUND YES NO


SEPTIC TANK PUMPED & FILLED YES NO X

CONTRACTOR Don Brewer

SPECIAL CONDITIONS _____

EXISTING HOME _____

NEW CONSTRUCTION X

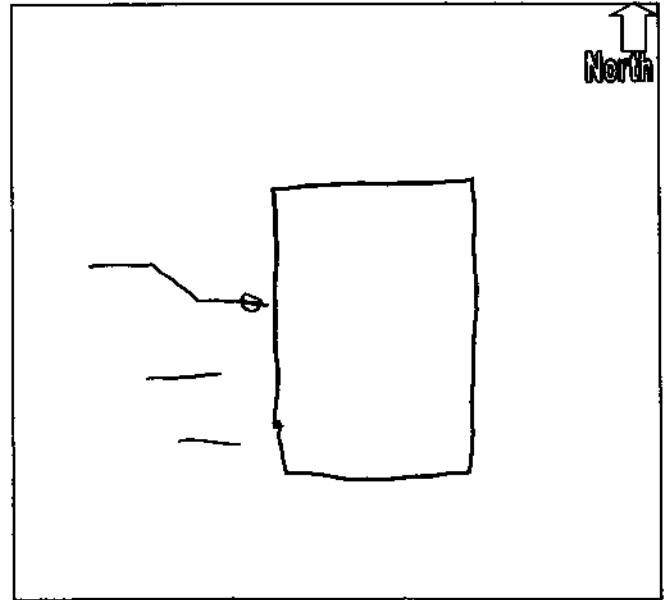

ROBERT G. TAYLOR, INC.
DALEVILLE, INDIANA 47334

0008893

FALLCREE
Fall Creek Regional Waste Dist

8893

06/26/02

Lot #114 Fiddlers Green

*****\$2,635.00

ORIGINAL DOCUMENT IS PRINTED ON CHEMICAL REACTIVE PAPER & HAS A MICROPRINTED BORDER



ROBERT G. TAYLOR, INC.
8880 SOUTH CR. 800 WEST
DALEVILLE, INDIANA 47334



First Merchants Bank
First Merchants Bank, N.A. Muncie, Indiana

71-65/749

0008893
NUMBER

8893

PAY:

TWO THOUSAND SIX HUNDRED THIRTY-FIVE DOLLARS

DATE

AMOUNT

06/26/02

*****\$2,635.00

TO THE

ORDER

OF

Fall Creek Regional Waste Dist
P.O. Box 59
Pendleton, In. 46064

ROBERT G. TAYLOR, INC.

Cindy L. Costen

THE REVERSE SIDE OF THIS DOCUMENT INCLUDES AN ARTIFICIAL WATERMARK - HOLD AT AN ANGLE TO VIEW

⑈008893⑈ ⑆074900657⑆