



FALL CREEK REGIONAL WASTE DISTRICT

9378 S. 650 West PO Box 59
Pendleton, IN 46064-0059 778-7544

8-18453.00

APPLICATION FOR SEWER PERMIT

Nº 2323

Date 11/28/95

Permit Void 90 days from Date of Issuance

Owner Name Ron Hughes

Property Address 639 N Pendleton Ave.

Lot # P.O. Box

Town Pendleton, IN Zip Code 46064

Phone City Water Well

\$ 2700.00 Tap on Fee Paid 1/29/96

\$ 25.00 Inspection fee paid 1/29/96

Application is hereby made for connection to the Fall Creek Regional Waste District Sewer System for the above listed property - Permit Type: Residential ☒, Commercial ☐, Industrial ☐, or Governmental/Institutional ☐. User Information

All workmanship and materials shall conform to the standards of the District Ordinance as described in Ordinance 84-2 and 84-3 as amended. Acceptance and approval must be made by the District inspector or his duly authorized representative before backfilling and final connection is made to the main sewer lines. Any violation of applicable regulations will cause all lines and appurtenances in violation to be removed and replaced at the owners expense.

The Fall Creek Regional Waste District is responsible for the inspection, approval of materials, and installation techniques only. All costs for materials and installation and any liabilities resulting from same is the sole responsibility of the property owner.

I have read and fully understand the above provisions and agree to comply by said provisions.

APPLICANT(S) SIGNATURE

INSPECTOR Don

Date inspected 11-23-95 Approved ☒ Rejected ☐

Reason for rejection

Date reinspected Approved Rejected

Notes: Size Pipe 6" "

Type Pipe PVC

Basement Yes No ☒

Sump Pump Yes No ☒

Downspout to Ground Yes ☒ No


Septic Tank Pumped & filled Yes ☒ No

Contractor TONY SANDERS

Special Conditions

Existing Home

New Construction ☒

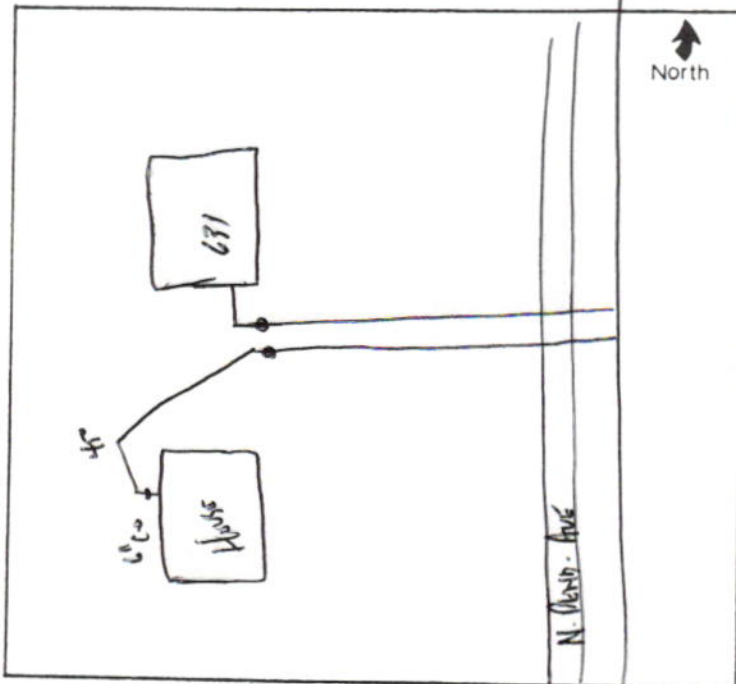



FALL CREEK REGIONAL WASTE DISTRICT

P.O. Box 59 • 9378 S. 650 West • Pendleton, Indiana 46064-0059 • (317) 778-7544

January 24, 1996

Mr. Don Hughes
639 N. Pendleton Avenue
Pendleton, IN 46064

RE: Sanitary sewer connection fees


Dear Mr. Hughes:

The purpose of this letter is to notify you of our sanitary sewer connection fees. Normally, when we extend our sanitary sewer lines into a new area, we send connect notices to the affected residents explaining connect procedures and fees. However, your residence was connected before we sent notices to your area.

There is a \$2700 residential tap-on fee and a \$25 inspection fee payable upon receipt of this notice. Payment may be made at our Administrative Office, 9378 S County Road 650 West, Pendleton, Indiana 46064. A Time Payment Plan is available for this fee. If you are interested in the details of the Time Payment Plan, please call our Office Manager at 778-7544.

We look forward to hearing from you.

Sincerely,


Lee F. Rowlett
General Manager