

Fall Creek Regional Waste District
9378 S 650 W, P.O. Box 59, Pendleton, IN 46064
765-778-7544

#6461

Agreement for Sanitary Sewer Service

This Agreement made and entered into this 29th day of MAY, 2013, between Fall Creek Regional Waste District ("District") and DENNIS & MARY KAT BEAN ("Applicant") regarding the provision of sanitary sewer service, and the assignment of capacity in and connection to, the District's facilities for the premises located at JEFFERSON PLACE, LOT 71.

6408 INDEPENDANCE COURT HALLMARK HOMES

Now therefore, the parties, in consideration of the mutual promises set out in this Agreement, the receipt and sufficiency of which is hereby acknowledged, agree as follows:

- 1. The Applicant agrees that all workmanship and materials shall conform to all District ordinances and the District's construction standards. District must accept and approve all work and materials before backfilling and final connection is made to the sewer mains. Any violation of this provision will cause all lines and appurtenances in violation to be removed and replaced at the Applicant's expense.
2. The District shall have the right to enter upon the Applicant's premises at all reasonable times to inspect, repair, or replace any equipment used in connection with the District's service or which has an impact on said service.
3. The Applicant shall be responsible for all monthly user rates, capacity charges, and tap fees. The failure to pay any rate charge or fee may result in a lien against the property and/or the termination of service to the property, the cost of which will be borne by Applicant, including, but not limited to, all attorney's fees and collection costs.
4. The District shall not be responsible for any damages as a result of any failure to supply service unless said damages are due to default, neglect or culpability on the part of the District.
5. If there is an available sanitary sewer within three hundred (300) feet of the property line, the property owner shall be required to connect to the District's sanitary sewer system.
6. The Applicant and District agree that the provision of sanitary sewer service touches and concerns the property and the terms of this Agreement bind the District and Applicant and their heirs, executors, administrators, personal representatives, successors, agents, attorneys, assigns, designees, and transferees.

The parties hereto have read and fully understand the above provisions and agree to comply with said provisions.

FALL CREEK REGIONAL WASTE DISTRICT
Signature: Rebecca A. McClintick

APPLICANT
Signature: Lynn Maddox

STATE OF INDIANA)
) SS:
COUNTY OF MADISON)



Commission Expires May 19, 2016
A Resident of
Madison County, Indiana
Rebecca A. McClintick, Notary Public

SUBSCRIBED and sworn to before me this 29th day of MAY, 2013

My Commission Expires:

Signature: Rebecca A. McClintick

FOR DEPOSIT ONLY
FALL CREEK REGIONAL WASTE
PENDLETON, INDIANA


Printed:
Notary Public
Resident of _____ County

Inspector: JT Date Inspected: 8-29-13 Approved: [check] Rejected: _____

Reason for Rejection: _____
Date Reinspected: _____ Approved: _____ Rejected: _____

Notes:

Size Pipe: 6" Type Pipe: SDR35
Basement: Yes No
Sump Pump: Yes No
Downspout to Ground: Yes No
Septic Tank Pumped & Filled: Yes No
Contractor: Chandler
Special Conditions:
Existing Home:
New Construction: [X]

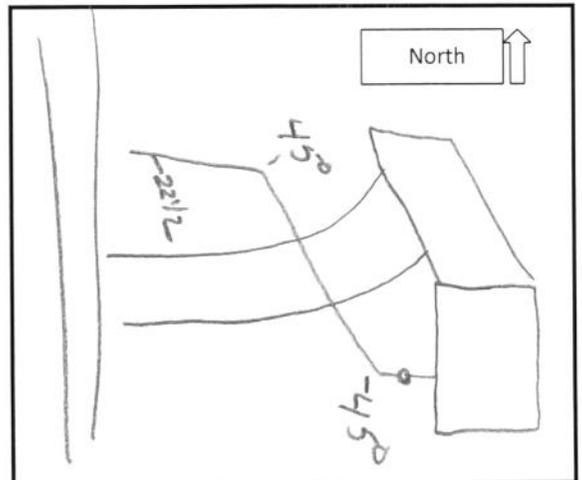

Commission Expires 12/31/2010
A Resolution of
The Board of Directors
Robert A. McCannick, Mayor, Fulton



FOR DEPOSIT ONLY
FALL GREEN REGIONAL WASTE
PERMITS, INDIANA

HALLMARK HOMES, INC.

433 E. 53RD STREET
ANDERSON, IN 46013
765-644-6566

STAR FINANCIAL BANK
INDIANAPOLIS, IN 46255
71-167749

113153

5/20/2013

PAY TO THE
ORDER OF

FCRWD

\$ 3,370.00

Three thousand three hundred seventy 00/100 DOLLARS

Deek Wills

MEMO BEAN SEWER TAP

⑈ 113153⑈ ⑆ 074901672⑆

⑈ 110 38097⑈

© 2011 INTUIT INC. # 225 1-800-433-8810