


4865

765-778-7544

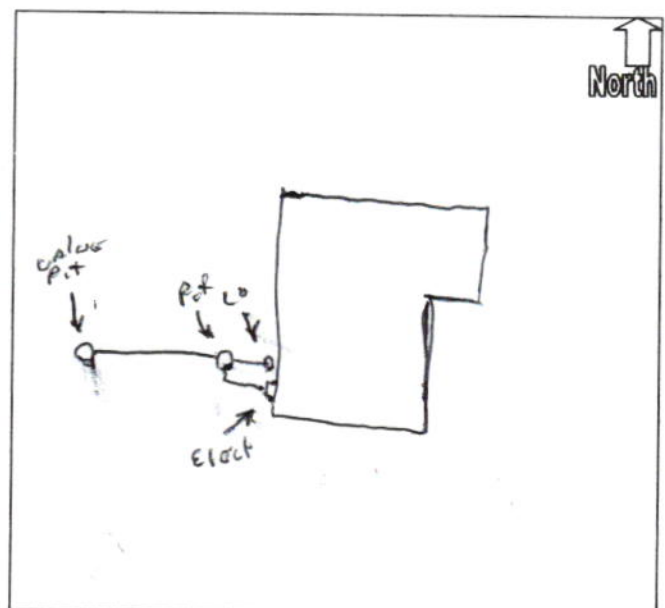

VENDEL-WILSON VENTURES

600 E. BROADWAY
FORTVILLE, IN 46040-1546

3673

Date 6-6-03


71-367/749
06

Pay to the
Order of F. Q. R. W. D.

\$ 2635⁰⁰/₁₀₀

TWENTY SIX HUNDRED THIRTY FIVE + ⁰⁰/₁₀₀ Dollars

 Security features
are included
Details on back.


GREENFIELD BANKING COMPANY
FORTVILLE, IN 46040

For _____



MP

⑆074903670⑆

⑈ 03673

MAROON SHEFFIELD WMSF

B.L. BROWN
CONSTRUCTION & EXCAVATION, INC.

P.O. BOX 294
PENDLETON, IN 46064-0294
(765) 778-4120

08-963333

MADISON COMMUNITY BANK
71-553/749

4040

6/9/03

PAY TO THE
ORDER OF

FCRWD

\$ 1034 ⁵⁶/₁₀₀

One Thousand Thirty Four

⁵⁶/₁₀₀ DOLLARS

MEMO:

B.L. Brown

⑈004040⑈

SECURITY FEATURES: MICRO PRINT TOP & BOTTOM BORDERS - COLORED PATTERN - ARTIFICIAL WATERMARK ON REVERSE SIDE - MISSING FEATURE INDICATES A COPY