



FALL CREEK REGIONAL WASTE DISTRICT

9378 S. 650 West PO Box 59  
Pendleton, IN 46064-0059 778-7544

26-09020.00

add order  
on file

APPLICATION FOR SEWER PERMIT

Nº 2835

Date 05JL00

Permit Void 90 days from Date of Issuance

Owner Name R. ANTHONY SOVERNS

Property Address 6413 INDEPENDENCE CT.

Lot # 3 P.O. Box N/A

Town PENDLETON, IN Zip Code 46064

Phone 765-778-8375 City Water        Well ✓

\$ 2556.00 Tap on Fee Paid Larry Fredericks - Contractor  
\$        ~~Inspection fee paid~~

Application is hereby made for connection to the Fall Creek Regional Waste District Sewer System for the above listed property - Permit Type: Residential ✓, Commercial       , Industrial       , or Governmental/Institutional       . User Information       .

All workmanship and materials shall conform to the standards of the District Ordinance as described in Ordinance 84-2 and 84-3 as amended. Acceptance and approval must be made by the District inspector or his duly authorized representative before backfilling and final connection is made to the main sewer lines. Any violation of applicable regulations will cause all lines and appurtenances in violation to be removed and replaced at the owners expense.

The Fall Creek Regional Waste District is responsible for the inspection, approval of materials, and installation techniques only. All costs for materials and installation and any liabilities resulting from same is the sole responsibility of the property owner.

I have read and fully understand the above provisions and agree to comply by said provisions

R. Anthony Sovrens  
APPLICANT(S) SIGNATURE

INSPECTOR       

Date inspected 7-6-00 Approved ✓ Rejected       

Reason for rejection       

Date reinspected        Approved        Rejected       

Notes:

Size Pipe 6 "

Type Pipe WC 35

Basement Yes        No ✓

Sump Pump Yes        No ✓

Downspout to Ground Yes ✓ No       


Septic Tank Pumped & filled Yes ✓ No       

Contractor Fredericks

Special Conditions       

Existing Home ✓

New Construction       

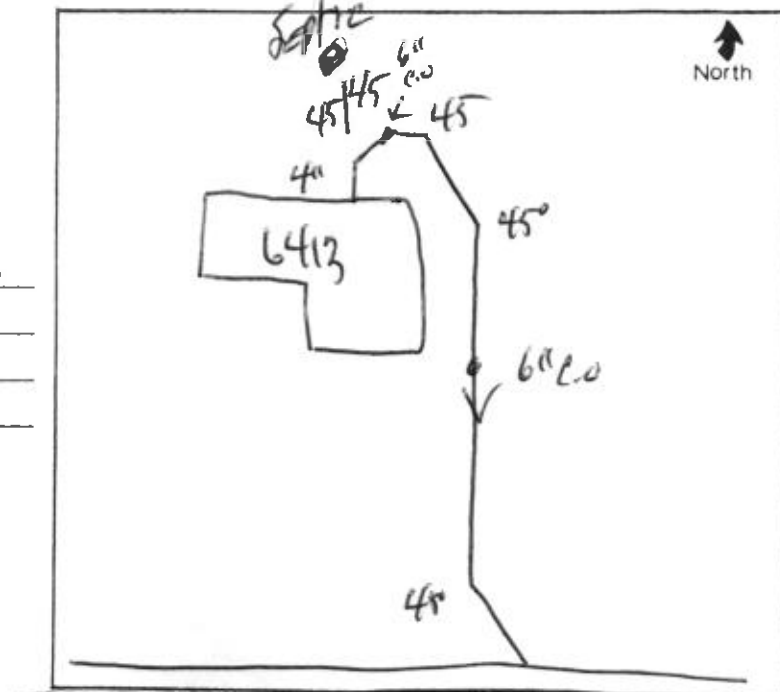

Handwritten notes at the top left corner.

Handwritten text in the upper middle section.

Handwritten text in the upper middle section.

Handwritten text in the middle section.

Handwritten text in the middle section.


Handwritten text in the middle section.

Handwritten text in the middle section.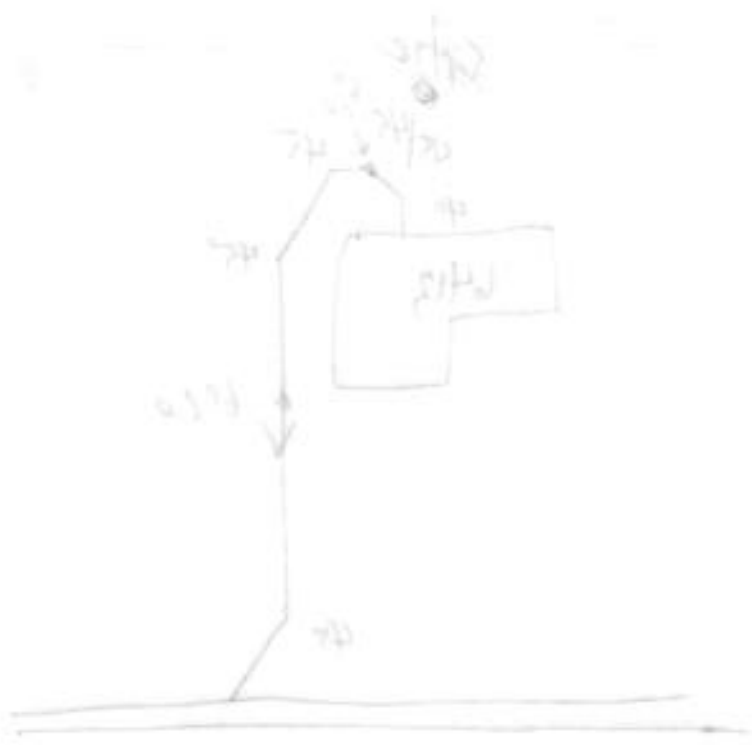

9378 S. CR 650 W.  
P.O. Box 59  
Pendleton, IN 46064  
Phone: 765-778-7544

**INVOICE**

Customer		Project Area # D	
Name	Anthony Soverns	Acct #	
Address	6413 S Independence Court	W.O. #	9915
City	Pendleton	State	IN
Phone		Zip	46064
			Due Date 90 days

DATE	PAYMENT	CHECK NUMBER	AMOUNT
		Sub-Total	\$0.00

*Detach bottom portion and return with payment*

**Cut here**

<b>Customer</b>					
Name	Anthony Soverns	Acct #		Project Area #	D
Address	6413 S Independence Court			W.O. #	9915
City	Pendleton	State	IN	Due Date	90 days
Phone		Zip	46064		
			0		
				<b>Amount Due</b>	<b>\$2,556.00</b>

