

22-23345.00



## FALL CREEK REGIONAL WASTE DISTRICT

9378 S. 650 West PO Box 59  
Pendleton, IN 46064-0059 778-7544

## APPLICATION FOR SEWER PERMIT

No 2717

Date 11-23-99

Permit Void 90 days from Date of Issuance

Owner Name Willie BolesProperty Address 641 E. US 36 P

Lot # \_\_\_\_\_ P.O. Box \_\_\_\_\_

Town Pendleton, IN Zip Code 46064Phone 765-779-4556 City Water \_\_\_\_\_ Well ☒\$ 2556.00 Tap on Fee Paid

\$ \_\_\_\_\_ Inspection fee paid

Application is hereby made for connection to the Fall Creek Regional Waste District Sewer System for the above listed property - Permit Type: Residential ☒, Commercial \_\_\_\_\_, Industrial \_\_\_\_\_, or Governmental/Institutional \_\_\_\_\_. User Information \_\_\_\_\_.

All workmanship and materials shall conform to the standards of the District Ordinance as described in Ordinance 84-2 and 84-3 as amended. Acceptance and approval must be made by the District inspector or his duly authorized representative before backfilling and final connection is made to the main sewer lines. Any violation of applicable regulations will cause all lines and appurtenances in violation to be removed and replaced at the owners expense.

The Fall Creek Regional Waste District is responsible for the inspection, approval of materials, and installation techniques only. All costs for materials and installation and any liabilities resulting from same is the sole responsibility of the property owner.

I have read and fully understand the above provisions and agree to comply by said provisions.

Willie Boles  
APPLICANT(S) SIGNATURE

INSPECTOR Don/BowDate inspected 11-23-99 Approved ☒ Rejected \_\_\_\_\_

Reason for rejection \_\_\_\_\_

Date reinspected \_\_\_\_\_ Approved \_\_\_\_\_ Rejected \_\_\_\_\_

Notes: 4" LAF- / 1 1/2" FMSize Pipe PVCType Pipe PVCBasement Yes ☒ No \_\_\_\_\_

Sump Pump Yes \_\_\_\_\_ No \_\_\_\_\_

Downspout to Ground Yes ☒ No \_\_\_\_\_

Septic Tank Pumped &amp; filled Yes \_\_\_\_\_ No \_\_\_\_\_

Contractor EMIL DAMS


Special Conditions \_\_\_\_\_

Existing Home ☒

New Construction \_\_\_\_\_





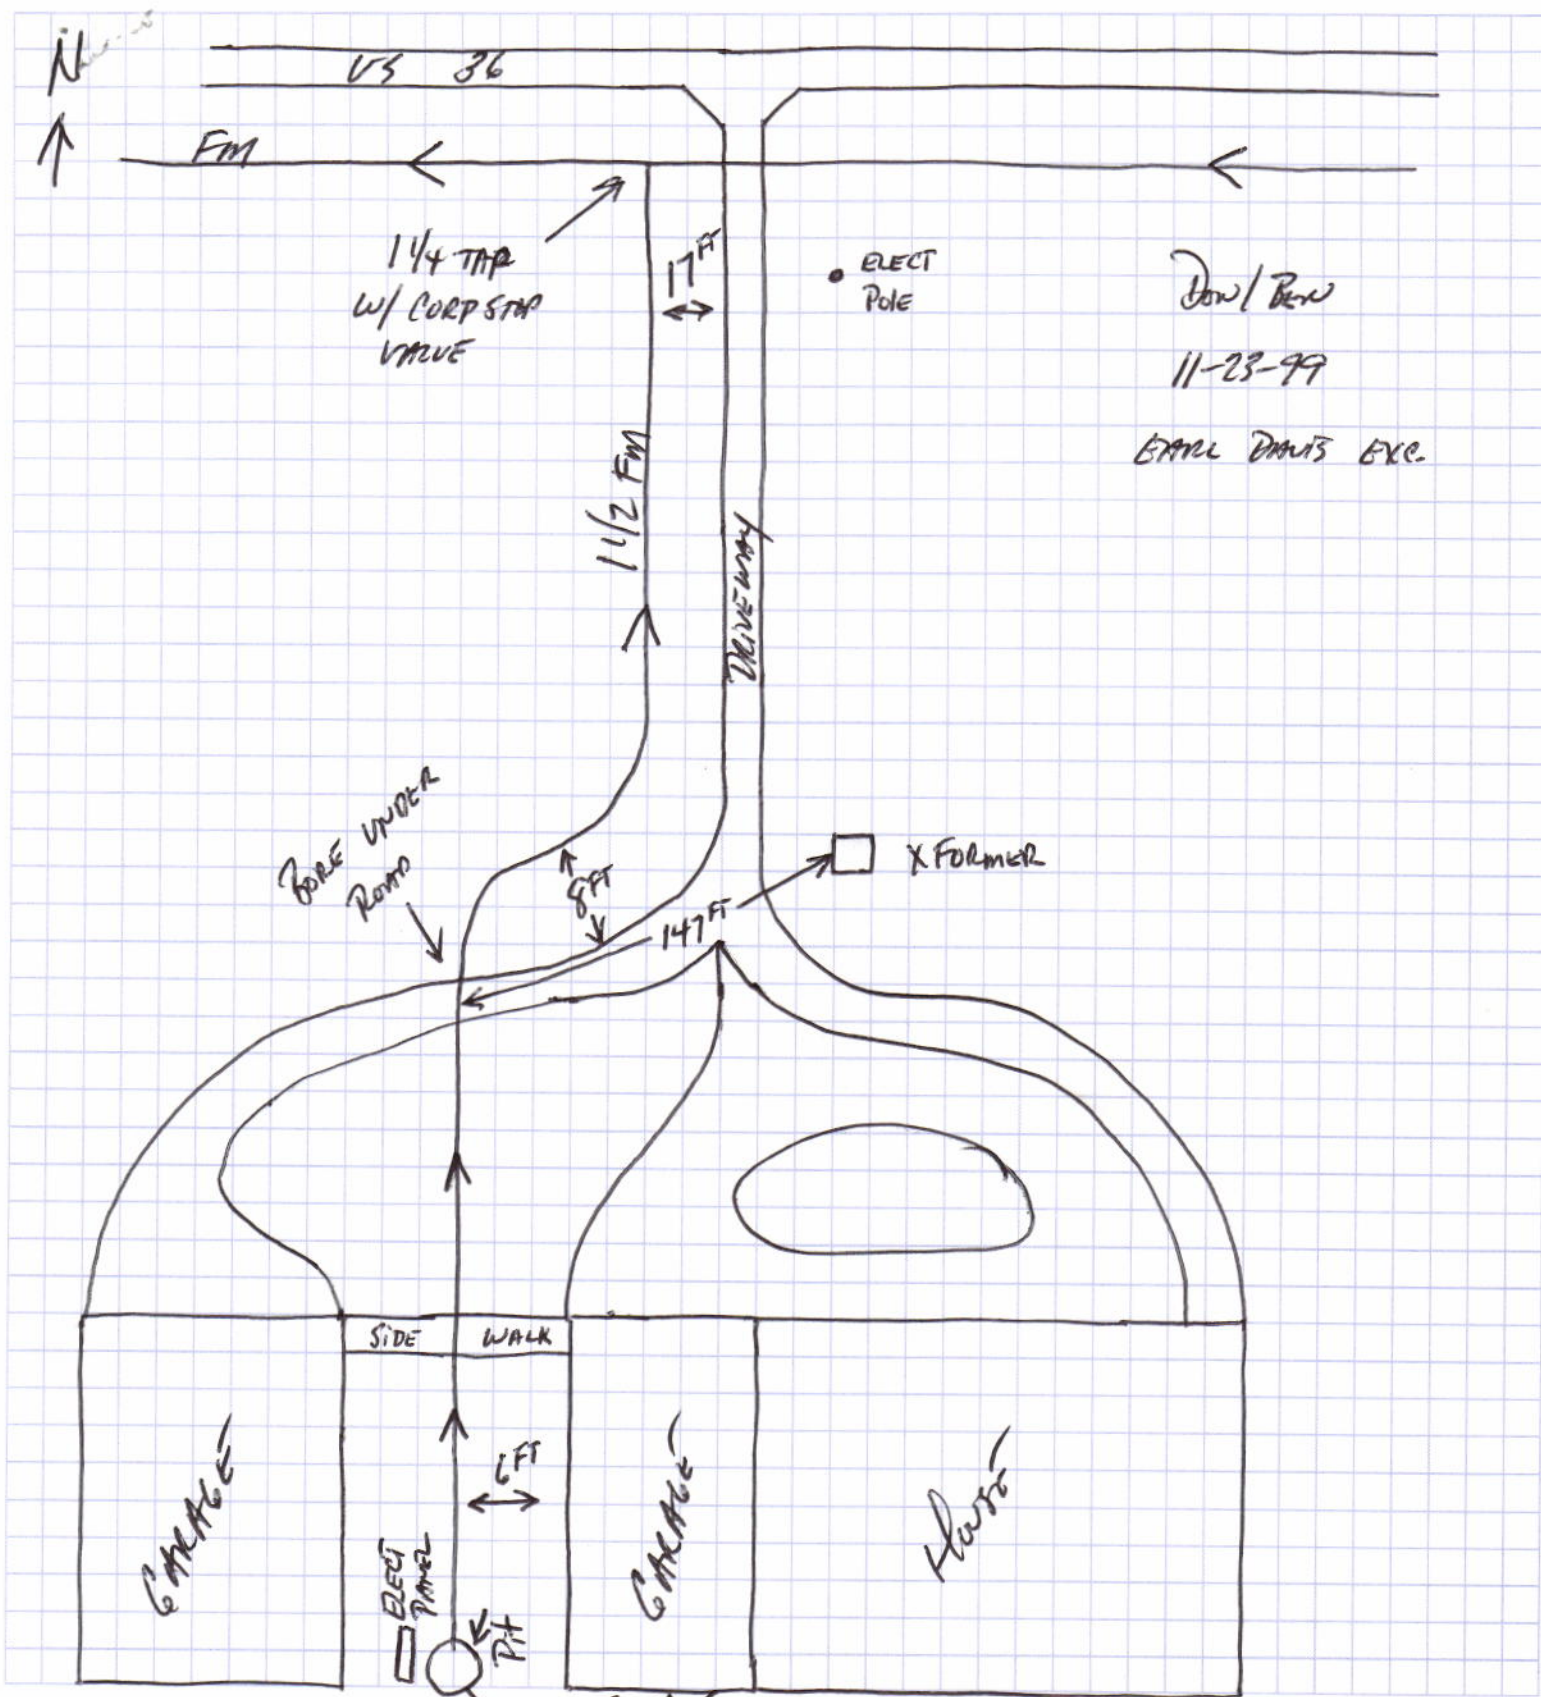

# INDEPENDENT CONCRETE PIPE COMPANY



SALES OFFICES	TELEPHONE
INDIANAPOLIS, IN	317/262-4920
MISHAWAKA, IN	219/259-5401
ST. LOUIS, MO	314/842-2900
LOUISVILLE, KY	502/448-2920
TOLEDO, OH	419/841-3361

Septic Tank C.O.

PROJECT \_\_\_\_\_

ITEM \_\_\_\_\_

DESIGNED \_\_\_\_\_ CHECKED \_\_\_\_\_

DATE \_\_\_\_\_