

Gidw.

PROJECT Phase II SHEET _____ OF _____


SUBJECT _____ DATE 6-19-18

JOB NO. 4447

BY AHAS

643/645 S. Silver

← N

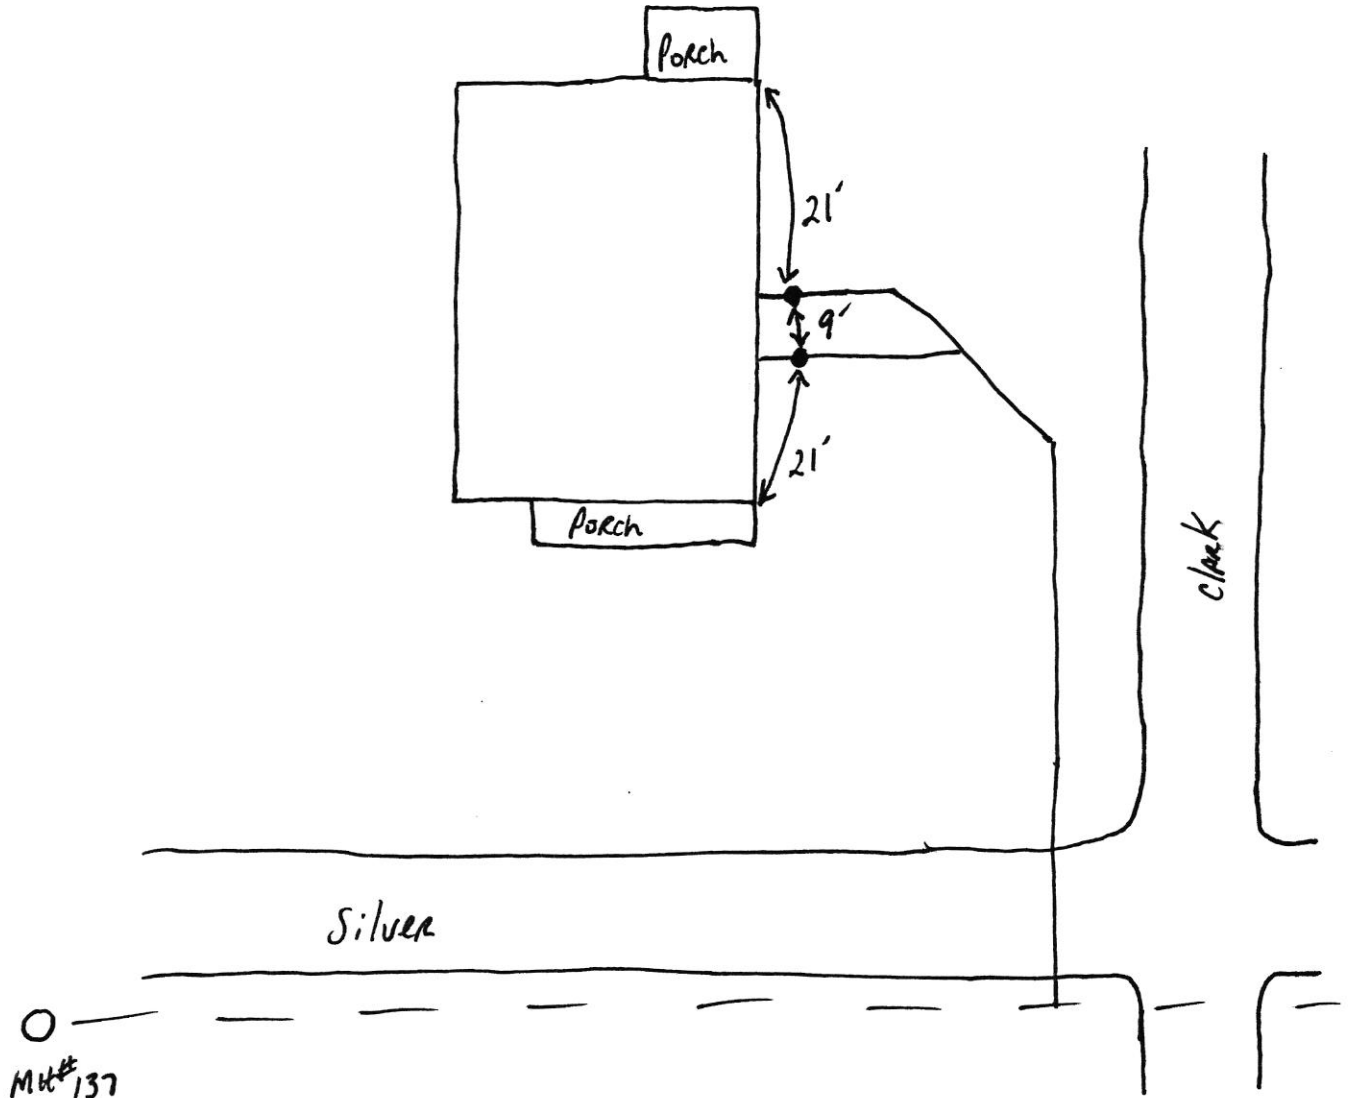

U43-U45 Silver

SPT Phase II

4.21.18

