

Fall Creek Regional Waste District
9378 S 650 W, P.O. Box 59, Pendleton, IN 46064
765-778-7544

#6463

Agreement for Sanitary Sewer Service

Hallmark Homes

This Agreement made and entered into this 16 day of July, 2013, between Fall Creek Regional Waste District ("District") and Bradley Buck ("Applicant") regarding the provision of sanitary sewer service, and the assignment of capacity in and connection to, the District's facilities for the premises located at Lot 72 Jefferson Place
6430 Independence

Now therefore, the parties, in consideration of the mutual promises set out in this Agreement, the receipt and sufficiency of which is hereby acknowledged, agree as follows:

1. The Applicant agrees that all workmanship and materials shall conform to all District ordinances and the District's construction standards. District must accept and approve all work and materials before backfilling and final connection is made to the sewer mains. Any violation of this provision will cause all lines and appurtenances in violation to be removed and replaced at the Applicant's expense.
2. The District shall have the right to enter upon the Applicant's premises at all reasonable times to inspect, repair, or replace any equipment used in connection with the District's service or which has an impact on said service.
3. The Applicant shall be responsible for all monthly user rates, capacity charges, and tap fees. The failure to pay any rate charge or fee may result in a lien against the property and/or the termination of service to the property, the cost of which will be borne by Applicant, including, but not limited to, all attorney's fees and collection costs.
4. The District shall not be responsible for any damages as a result of any failure to supply service unless said damages are due to default, neglect or culpability on the part of the District.
5. If there is an available sanitary sewer within three hundred (300) feet of the property line, the property owner shall be required to connect to the District's sanitary sewer system.
6. The Applicant and District agree that the provision of sanitary sewer service touches and concerns the property and the terms of this Agreement bind the District and Applicant and their heirs, executors, administrators, personal representatives, successors, agents, attorneys, assigns, designees, and transferees.

The parties hereto have read and fully understand the above provisions and agree to comply with said provisions.

FALL CREEK REGIONAL WASTE DISTRICT
Rebecca Lynn Hunter
Signature

APPLICANT
Lynn Madden
Signature

STATE OF INDIANA)
) SS:
COUNTY OF MADISON)

SUBSCRIBED and sworn to before me this 16 day of July, 2013

My Commission Expires:



Commission Expires November 20, 2015
A Resident of
Hamilton County, Indiana
Rebecca Lynn Hunter, Notary Public

Signature

Printed

Notary Public

Resident of Hamilton County

Inspector JT Date Inspected 8-29-13 Approved ✓ Rejected _____

Reason for Rejection _____

Date Reinspected _____ Approved _____ Rejected _____

Notes:

Size Pipe 6" Type Pipe SDR35

Basement Yes _____ No _____

Sump Pump Yes _____ No _____

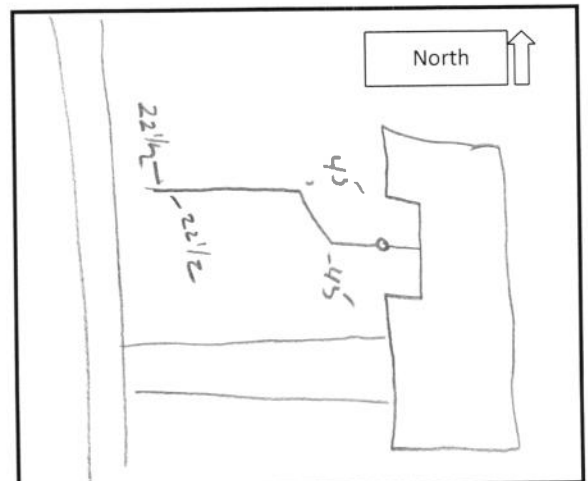
Downspout to Ground Yes _____ No _____

Septic Tank Pumped & Filled Yes _____ No _____

Contractor Chandler

Special Conditions _____

Existing Home _____

New Construction X

Brack^{nutley} Buck

6430 Independence Ct.

lot. 72 Jefferson Place

Commission Expires November 20, 2012
A Record of
William C. Madden
Rebecca Lynn Madden Jones



COPY

CASH ONLY IF ALL CheckLock™ SECURITY FEATURES LISTED ON BACK INDICATE NO TAMPERING OR COPYING

HALLMARK HOMES, INC.

433 E. 53RD STREET
ANDERSON, IN 46013
765-644-6566

STAR FINANCIAL BANK
INDIANAPOLIS, IN 46255
71-167749

113407

7/16/2013

PAY TO THE
ORDER OF

FCRWD

\$ 3370.00

Three thousand three hundred seventy 00/100 DOLLARS

MEMO

Buck Sewer

⑈ 113407 ⑈

Deek Wille

Details on Back
Intuit® CheckLock™ Secure Check

Tap

\$570.00

Capacity

\$2800.00