


North 

Drawing  
+  
2 pictures  
attached




Carrick Glen Lot #145  
Wills Ex.

11/16/22

→ N

643 Blarney Dr.

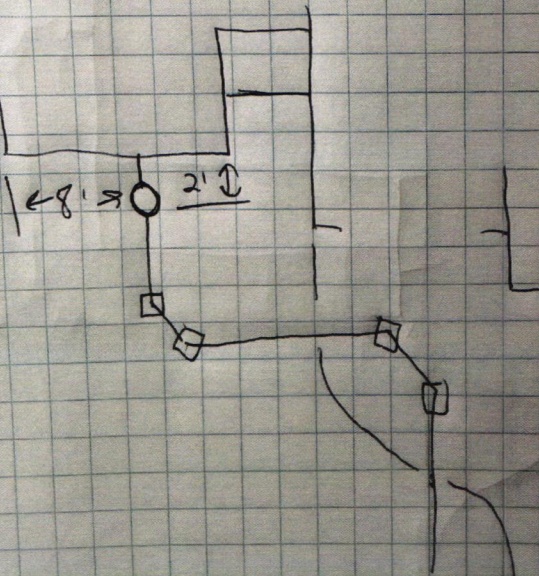











THIS CHECK IS PRINTED IN RED AND BLUE INK ON THE FACE ON CHEMICAL AND BLEACH REACTIVE PAPER WITH INVISIBLE FLUORESCENT FIBERS AND BASKETWEAVE ON BACK MP

**D.R. HORTON**  
America's Builder

JP Morgan Chase Bank, N.A.  
Syracuse, NY

Check Number 1466670

DRH Inc. Controlled Disb  
1341 Horton Circle  
Arlington, TX 76011

50-937  
213  
2720128

Date	Amount
03/09/22	\$*****760.00

Void after 6 months from date of issue

SEVEN HUNDRED SIXTY AND 00/100 \*\*\*\*\*

Pay To The Order Of:  
FALL CREEK REGIONAL WASTE DISTRICT  
9378 SOUTH 650 WEST  
PENDLETON IN 46064

*D. L. Horton*

CG145