

#6462

Agreement for Sanitary Sewer Service

20- 09490.00

Tim Edwards

This Agreement made and entered into this 20th day of JUNE, 2013, between Fall Creek Regional Waste District ("District") and ROD HOLLOWAY HOMES ("Applicant") regarding the provision of sanitary sewer service, and the assignment of capacity in and connection to, the District's facilities for the premises located at JEFFERSON PLACE, LOT 73.

Now therefore, the parties, in consideration of the mutual promises set out in this Agreement, the receipt and sufficiency of which is hereby acknowledged, agree as follows:

1. The Applicant agrees that all workmanship and materials shall conform to all District ordinances and the District's construction standards. District must accept and approve all work and materials before backfilling and final connection is made to the sewer mains. Any violation of this provision will cause all lines and appurtenances in violation to be removed and replaced at the Applicant's expense.
2. The District shall have the right to enter upon the Applicant's premises at all reasonable times to inspect, repair, or replace any equipment used in connection with the District's service or which has an impact on said service.
3. The Applicant shall be responsible for all monthly user rates, capacity charges, and tap fees. The failure to pay any rate charge or fee may result in a lien against the property and/or the termination of service to the property, the cost of which will be borne by Applicant, including, but not limited to, all attorney's fees and collection costs.
4. The District shall not be responsible for any damages as a result of any failure to supply service unless said damages are due to default, neglect or culpability on the part of the District.
5. If there is an available sanitary sewer within three hundred (300) feet of the property line, the property owner shall be required to connect to the District's sanitary sewer system.
6. The Applicant and District agree that the provision of sanitary sewer service touches and concerns the property and the terms of this Agreement bind the District and Applicant and their heirs, executors, administrators, personal representatives, successors, agents, attorneys, assigns, designees, and transferees.

The parties hereto have read and fully understand the above provisions and agree to comply with said provisions.

FALL CREEK REGIONAL WASTE DISTRICT

Rebecca J. McClintick
Signature

APPLICANT

Signature

[illegible]

SUBSCRIBED and sworn to before me this 20th day of JUNE, 20 13

My Commission Expires:

Signature Talissa J. McClintick

**Commission Expires May 19, 2016**

A Resident of

Madison County, Indiana

Rebecca A. McClintick, Notary Public

Printed

Notary Public

Resident of _____ County _____

Inspector Don Date Inspected 7-25-19 Approved ✓ Rejected

Reason for Rejection

Date Reinspected _____ Approved _____ Rejected _____

Notes:

Size Pipe 6 Type Pipe PVC

Basement Yes No

Sump Pump Yes No

Downspout to Ground	Yes	No
---------------------	-----	----


Septic Tank Pumped & Filled Yes No

Contractor SL Brown

Special Conditions _____

Existing Home _____

New Construction

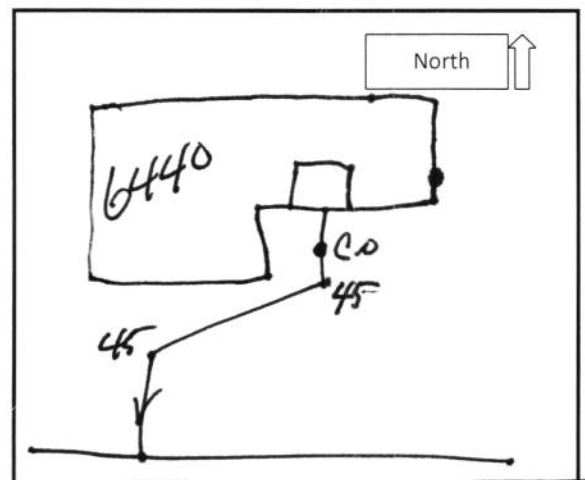

Идеология

Consultation Report
 A report of
 Mr. J. H. Smith
 Professor of Mathematics, University of
 California, Berkeley, California



J. H. Smith
 J. H. Smith

ROD HOLLOWAY HOMES, INC

765-208-0244
325 E. 1000 S.
PENDLETON, IN 46064

6-20-13

Fall Creek Regional Waste District

PAY TO THE
ORDER OF

\$ 3370.00

Three thousand three hundred seventy and 00/100

DOLLARS

MEMO Lot #73 Jefferson Pl.

Rodney C. Holloway
AUTHORIZED SIGNATURE

⑈001057⑈ ⑆074001048⑆ 149301013277⑈