



FALL CREEK REGIONAL WASTE DISTRICT

9378 S. 650 West PO Box 59
Pendleton, IN 46064-0059 778-7544

26-09010.00

add order
on file

APPLICATION FOR SEWER PERMIT

Nº 2801

Date

June 8, 2000

Permit Void 90 days from Date of Issuance

Owner Name

Victor & Michelle Stark

Property Address

6441 S. Independence Ct

Lot #

2

P.O. Box

Town

Pendleton

IN

Zip Code

46064

Phone

778-2018

City Water

Well

✓

\$ 2556.00

Tap on Fee Paid

Contractor - Jerry Fredericks

\$

Inspection fee paid

Application is hereby made for connection to the Fall Creek Regional Waste District Sewer System for the above listed property - Permit Type: Residential ☒, Commercial ☐, Industrial ☐, or Governmental/Institutional ☐. User Information

All workmanship and materials shall conform to the standards of the District Ordinance as described in Ordinance 84-2 and 84-3 as amended. Acceptance and approval must be made by the District inspector or his duly authorized representative before backfilling and final connection is made to the main sewer lines. Any violation of applicable regulations will cause all lines and appurtenances in violation to be removed and replaced at the owners expense.

The Fall Creek Regional Waste District is responsible for the inspection, approval of materials, and installation techniques only. All costs for materials and installation and any liabilities resulting from same is the sole responsibility of the property owner.

I have read and fully understand the above provisions and agree to comply by said provisions.

Michelle R. Stark

APPLICANT(S) SIGNATURE

INSPECTOR

Date inspected

7-5-00

Approved

✓

Rejected

Reason for rejection

Date reinspected

Approved

Rejected

Notes:

Size Pipe

6"

Type Pipe

SDR 35

Basement

Yes

No

Sump Pump

Yes

No

Downspout to Ground

Yes

No

Septic Tank pumped & filled

Yes

No

Contractor


Fredericks

Special Conditions

Existing Home

✓

New Construction

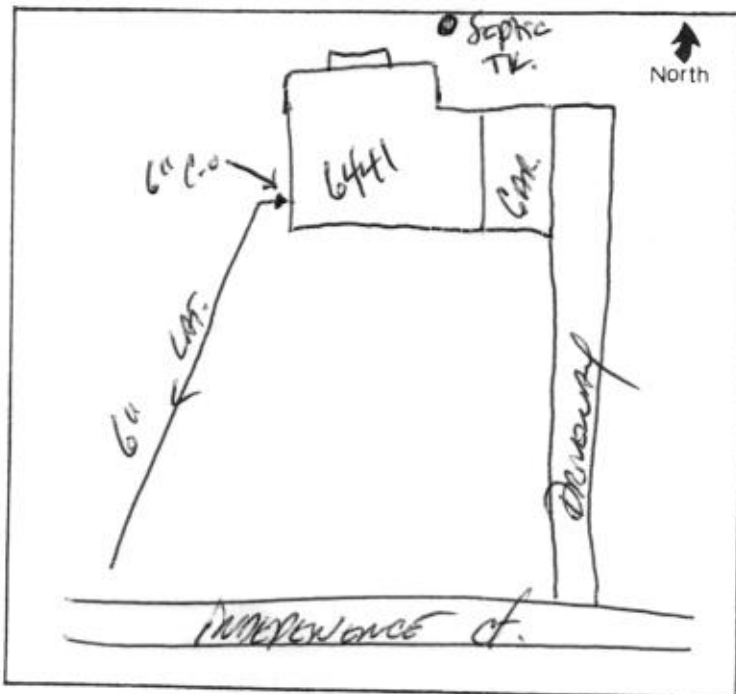

9378 S. CR 650 W.
P.O. Box 59
Pendleton, IN 46064
Phone: 765-778-7544

INVOICE

Customer							
Name	<u>Victor Stark</u>	Acct #	<u></u>			Project Area #	D
Address	<u>6441 S Independence Court</u>					W.O. #	9915
City	<u>Pendleton</u>	State	<u>IN</u>	Zip	<u>46064</u>	Due Date	90 days
Phone	<u></u>						

DATE	PAYMENT	CHECK NUMBER	AMOUNT
		Sub-Total	\$0.00

Cut here

Customer					
Name	Victor Stark	Acct #		Project Area #	D
Address	6441 S Independence Court			W.O. #	9915
City	Pendleton	State	IN	Due Date	90 days
Phone		Zip	46064		
			0		
				Amount Due	\$2,556.00