



FALL CREEK REGIONAL WASTE DISTRICT

9378 S. 650 West PO Box 59
Pendleton, IN 46064-0059 778-7544

26-09040.00

add order
on file

Contractor: Gerry Fredericks

No 2785

APPLICATION FOR SEWER PERMIT

Date 5/31/00

Permit Void 90 days from Date of Issuance

Owner Name Jon Maynard

Property Address 6443 W Congress Drive

Lot # 5 P.O. Box _____

Town Pendleton IN Zip Code 46064

Phone _____ City Water _____ Well ☒

\$ 400 Tap on Fee Paid

\$ 2156 Capacity Inspection fee paid

Application is hereby made for connection to the Fall Creek Regional Waste District Sewer System for the above listed property - Permit Type: Residential ☒, Commercial _____, Industrial _____, or Governmental/Institutional _____. User Information _____

All workmanship and materials shall conform to the standards of the District Ordinance as described in Ordinance 84-2 and 84-3 as amended. Acceptance and approval must be made by the District inspector or his duly authorized representative before backfilling and final connection is made to the main sewer lines. Any violation of applicable regulations will cause all lines and appurtenances in violation to be removed and replaced at the owners expense.

The Fall Creek Regional Waste District is responsible for the inspection, approval of materials, and installation techniques only. All costs for materials and installation and any liabilities resulting from same is the sole responsibility of the property owner.

I have read and fully understand the above provisions and agree to comply by said provisions.

Jon Maynard
APPLICANT(S) SIGNATURE

INSPECTOR Bow/Dan

Date inspected 6-29-00 Approved ☒ Rejected _____

Reason for rejection _____

Date reinspected _____ Approved _____ Rejected _____

Notes:

Size Pipe 6"

Type Pipe PVC

Basement Yes _____ No ☒

Sump Pump Yes _____ No ☒

Downspout to Ground Yes ☒ No _____ ?


Septic Tank Pumped & filled Yes ☒ No _____

Contractor GERRY FREDRICKS

Special Conditions _____

Existing Home ☒

New Construction _____

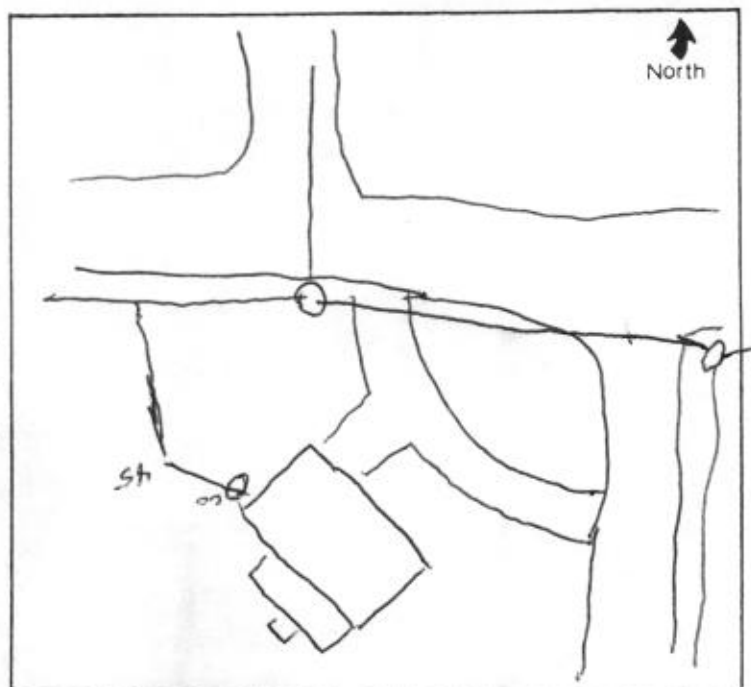

not under
in file

36-0440-00

FALL CREEK REGIONAL WASTE DISTRICT
8375 E. 630 West PO Box 29
Sandwich, IN 46070-0029 317-334-7314



Center for: Spring Breakers

N. 2785

STATION FOR WASTE TREATMENT

2/11/10

Date

Project Title: Waste Treatment Station

Owner Name: Jon H. H. H.

Property Address: 1443 W. Congress Drive

City: Ellettsville

State: IN

Zip: 46015

Map Sheet: 46015

Scale: 1 inch = 1 mile

Background: The project is located on the east side of the town of Ellettsville, Indiana. The project area is currently undeveloped and is adjacent to the town's water treatment plant. The project is intended to provide a permanent home for the town's waste treatment plant. The project is located on the east side of the town of Ellettsville, Indiana. The project area is currently undeveloped and is adjacent to the town's water treatment plant. The project is intended to provide a permanent home for the town's waste treatment plant.

All work, including but not limited to, design, construction, and operation of the project, shall be done in accordance with the standards of the Indiana Department of Environmental Protection. The project shall be designed to meet the standards of the Indiana Department of Environmental Protection. The project shall be constructed in accordance with the standards of the Indiana Department of Environmental Protection. The project shall be operated in accordance with the standards of the Indiana Department of Environmental Protection.

The town of Ellettsville, Indiana, is responsible for the design, construction, and operation of the project. The town of Ellettsville, Indiana, is responsible for the design, construction, and operation of the project. The town of Ellettsville, Indiana, is responsible for the design, construction, and operation of the project. The town of Ellettsville, Indiana, is responsible for the design, construction, and operation of the project.

Jon H. H. H.

Waste Treatment Station


1-2700

1-2700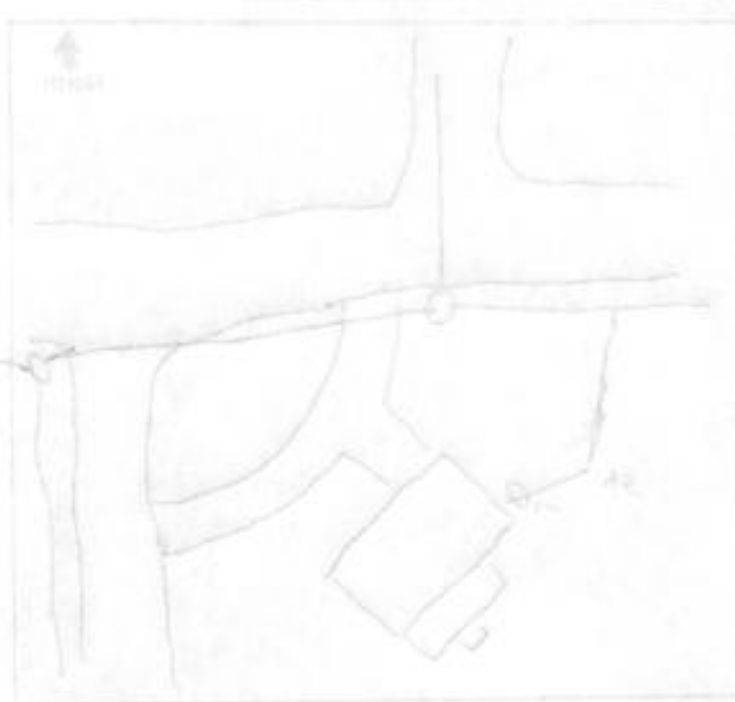

Project Title: Waste Treatment Station
Owner Name: Jon H. H. H.
Property Address: 1443 W. Congress Drive
City: Ellettsville
State: IN
Zip: 46015
Map Sheet: 46015
Scale: 1 inch = 1 mile
Background: The project is located on the east side of the town of Ellettsville, Indiana. The project area is currently undeveloped and is adjacent to the town's water treatment plant. The project is intended to provide a permanent home for the town's waste treatment plant. The project is located on the east side of the town of Ellettsville, Indiana. The project area is currently undeveloped and is adjacent to the town's water treatment plant. The project is intended to provide a permanent home for the town's waste treatment plant.

9378 S. CR 650 W.
P.O. Box 59
Pendleton, IN 46064
Phone: 765-778-7544

INVOICE

Name	Jon Maynard	Acct #	
Address	6443 W Congress Drive		
City	Pendleton	State	IN Zip 46064
Phone			

QTY	DESCRIPTION	UNIT PRICE	TOTAL
1	tap fee	\$400.00	\$400.00
1	capacity fee	\$2,156.00	\$2,156.00
		Sub-Total	\$2,556.00

DATE	PAYMENT	CHECK NUMBER	AMOUNT
		Sub-Total	\$0.00

Cut here

Name Jon Maynard Acct # _____
Address 6443 W Congress Drive
City Pendleton State IN Zip 46064
Phone _____

Project Area #	D
W.O. #	9915
Due Date	90 days

Amount Due	\$2,556.00
------------	------------