

G.R.W.

PROJECT Phase II SHEET _____ OF _____


SUBJECT _____ DATE 6-4-18

JOB NO. 4447

BY Atlas

644 S. Center

N →

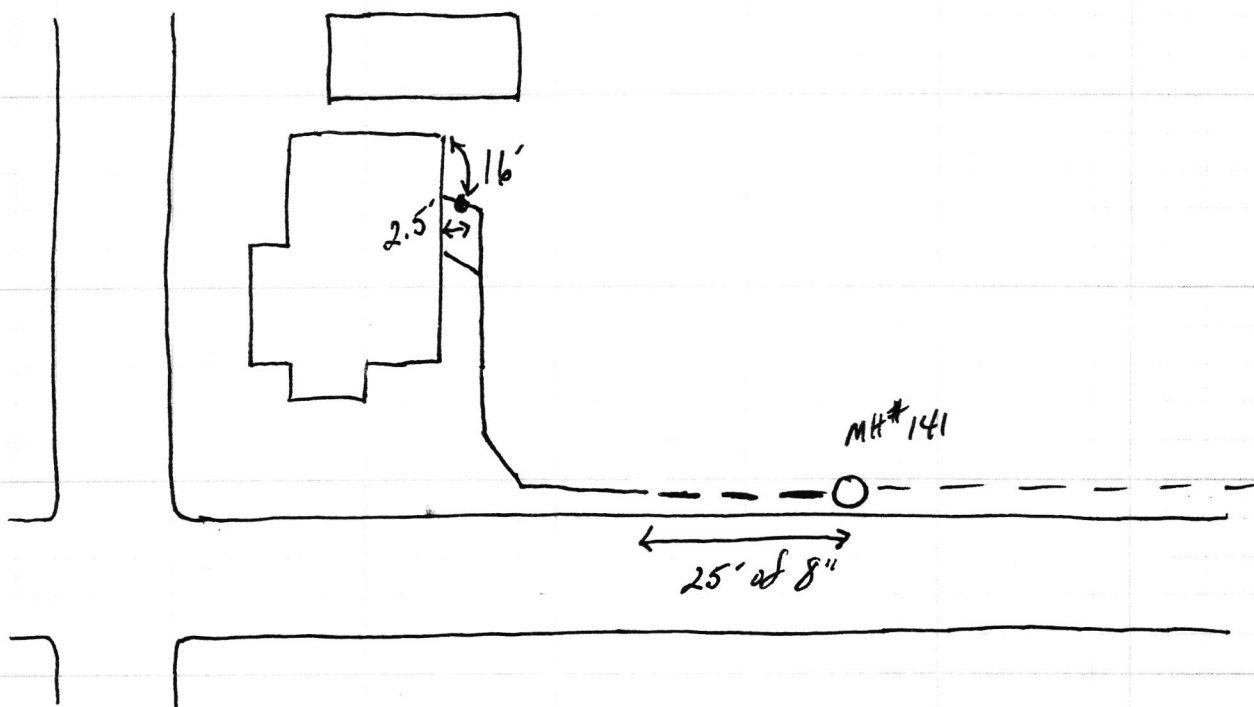

1044 S Center

SRP Phase II

10.11.18

