

Gidw.

PROJECT Phase II SHEET _____ OF _____


SUBJECT _____ DATE 5-30-18

JOB NO. 4447

BY Atlas

644 S. BROADWAY

↑
N

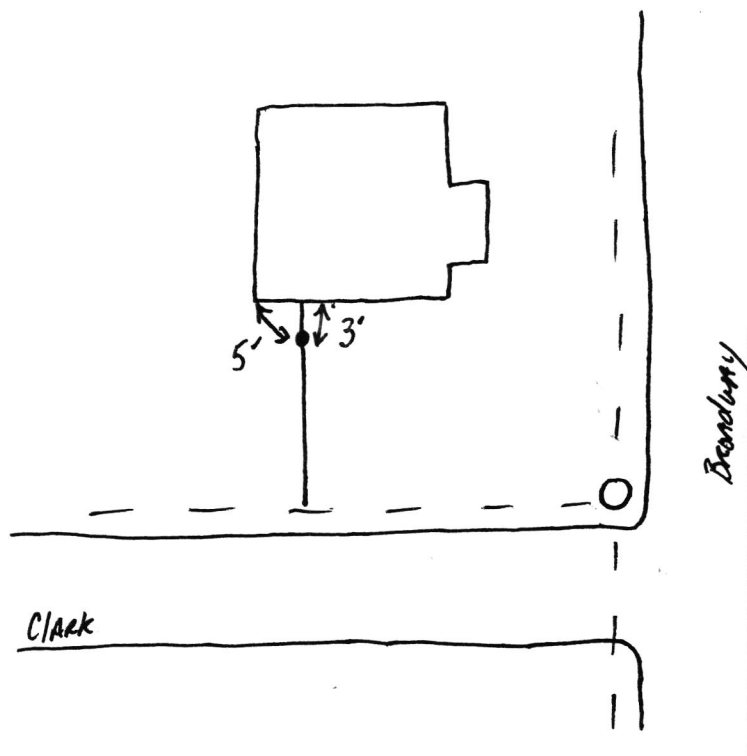

644 S Broadway

S&F Phase IV

6-2-18

