



# FALL CREEK REGIONAL WASTE DISTRICT

Box 44, Pendleton, Indiana 46064

210035500

1-800 355.00

No 000397

## APPLICATION FOR SEWER PERMIT

Permit No. \_\_\_\_\_ Date 10/25/85  
 Permit Void 90 days from Date of Issuance  
 Owner Name William Billrey  
 Property Address 645 Willow St.  
 Lot # \_\_\_\_\_ P.O. Box \_\_\_\_\_  
 Town Logans, IN Zip Code 46048  
 Phone \_\_\_\_\_ Water Meter 58"  
 \$ 150.00 Tap on Fee Paid  
 \$ 25.00 Inspection fee paid

Application is hereby made for connection to the Fall Creek Regional Waste District Sewer System for the above listed property - Permit Type: Residential X, Commercial \_\_\_\_\_, Industrial \_\_\_\_\_, or Governmental/Institutional \_\_\_\_\_. User Information \_\_\_\_\_.

All workmanship and materials shall conform to the standards of the District Ordinance as described in Ordinance 84-2 and 84-3 as amended. Acceptance and approval must be made by the District inspector or his duly authorized representative before backfilling and final connection is made to the main sewer lines. Any violation of applicable regulations will cause all lines and appurtenances in violation to be removed and replaced at the owners expense.

The Fall Creek Regional Waste District is responsible for the inspection, approval of materials, and installation techniques only. All costs for materials and installation and any liabilities resulting from same is the sole responsibility of the property owner.

I have read and fully understand the above provisions and agree to comply by said provisions.


William Billrey  
 APPLICANT(S) SIGNATURE

\*\*\*\*\*

INSPECTOR [Signature]  
 Date inspected 11/19/85 Approved [Signature] Rejected \_\_\_\_\_  
 Reason for rejection \_\_\_\_\_

Date reinspected \_\_\_\_\_ Approved \_\_\_\_\_ Rejected \_\_\_\_\_

Notes:  
 Size Pipe 6"  
 Type Pipe PVC  
 Basement Yes \_\_\_\_\_ No ✓  
 Sump Pump Yes \_\_\_\_\_ No ✓  
 Downspout to Ground Yes \_\_\_\_\_ No ✓  
 Septic Tank Pumped & filled Yes \_\_\_\_\_ No ✓  
 Contractor PASSMORE  
 Special Conditions \_\_\_\_\_

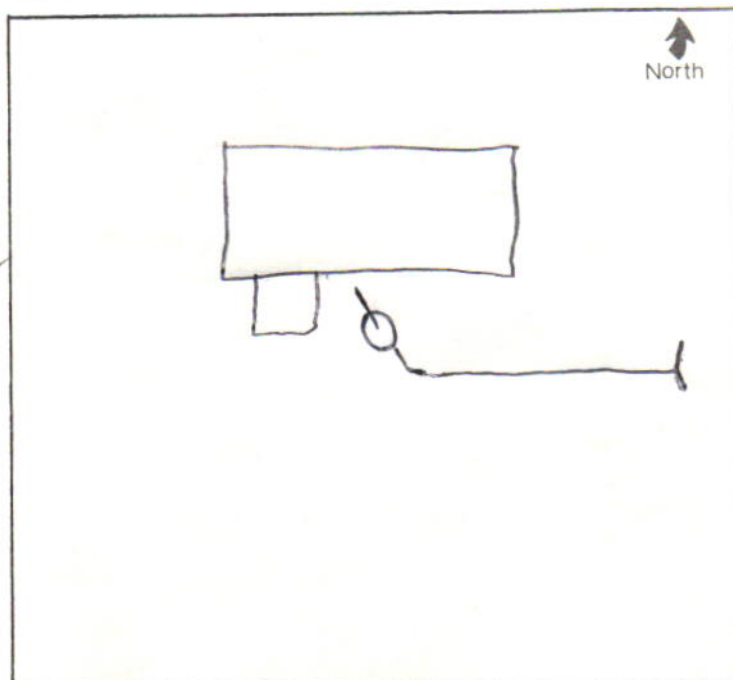

Sheet  
 14