



FALL CREEK REGIONAL WASTE DISTRICT

9378 S. 650 West PO Box 59
Pendleton, IN 46064-0059 778-7544

add order
on file

26-10000.00

317-201-5461
NED CRAIG

APPLICATION FOR SEWER PERMIT

Nº 2700

Date 8/30/99

Permit Void 90 days from Date of Issuance

Owner Name Steve Bourke

Property Address 6471 S. Fox Chase

Lot # 1, Fox Run P.O. Box _____

Town Pendleton IN Zip Code 46064

Phone _____ City Water _____ Well ☒

\$ 2556.00 Tap on Fee Paid 6/2/2000

\$ _____ Inspection fee paid

Application is hereby made for connection to the Fall Creek Regional Waste District Sewer System for the above listed property - Permit Type: Residential ☒, Commercial _____, Industrial _____, or Governmental/Institutional _____. User Information _____.

All workmanship and materials shall conform to the standards of the District Ordinance as described in Ordinance 84-2 and 84-3 as amended. Acceptance and approval must be made by the District inspector or his duly authorized representative before backfilling and final connection is made to the main sewer lines. Any violation of applicable regulations will cause all lines and appurtenances in violation to be removed and replaced at the owners expense.

The Fall Creek Regional Waste District is responsible for the inspection, approval of materials, and installation techniques only. All costs for materials and installation and any liabilities resulting from same is the sole responsibility of the property owner.

I have read and fully understand the above provisions and agree to comply by said provisions.

APPLICANT(S) SIGNATURE

9-8-99

INSPECTOR

Tim Dow

Date inspected 8-20-99 Approved ☒ Rejected _____

Reason for rejection _____

Date reinspected _____ Approved _____ Rejected _____

Notes:

Size Pipe 4"

Type Pipe Sch. 40

Basement Yes ☒ No _____

Sump Pump Yes _____ No ☒

Downspout to Ground Yes ☒ No _____

Septic Tank Pumped & filled Yes _____ No _____


Contractor NED CRAIG

Special Conditions Glue Joints

(PARTIAL INSPECTION)

Existing Home _____

New Construction ☒

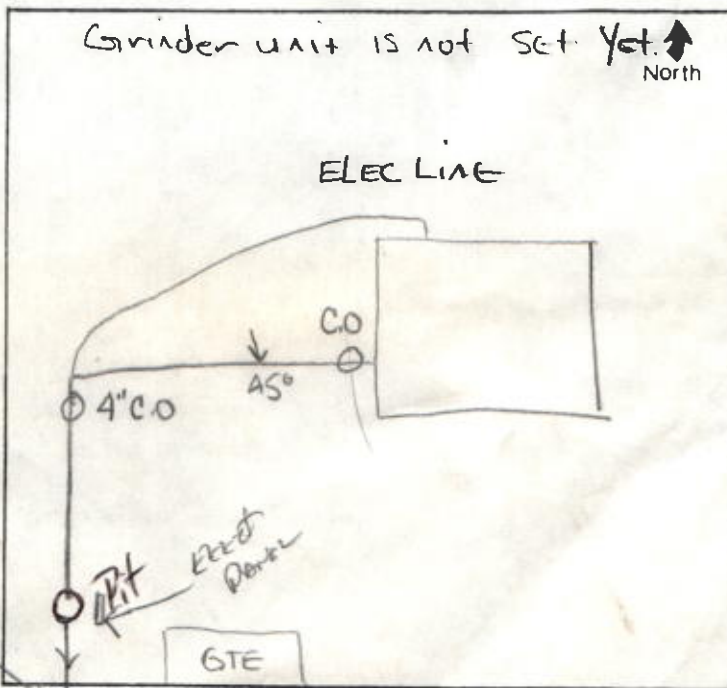

Set Pit 24" Below Crane
To Be Cut Down To Crane



Ned Craig 485-4519

original put
in Honie's
mailbox 8/15/00

FALL CREEK REGIONAL WASTE DISTRICT

9378 S. 650 West PO Box 59
Pendleton, IN 46064-0059 778-7544

APPLICATION FOR SEWER PERMIT

Nº 2700

Date

8/30/99

Permit Void 90 days from Date of Issuance

Owner Name

Steve Bourke

Property Address

6471 1/2 Fox Chase

Lot #

1, Fox Run

P.O. Box

Town

Pendleton

IN

Zip Code

46064

Phone

City Water

Well

✓

\$ 2556.00

Tap on Fee Paid

6/2/2000

\$

Inspection fee paid

Application is hereby made for connection to the Fall Creek Regional Waste District Sewer System for the above listed property - Permit Type: Residential ☒, Commercial ☐, Industrial ☐, or Governmental/Institutional ☐. User Information

All workmanship and materials shall conform to the standards of the District Ordinance as described in Ordinance 84-2 and 84-3 as amended. Acceptance and approval must be made by the District inspector or his duly authorized representative before backfilling and final connection is made to the main sewer lines. Any violation of applicable regulations will cause all lines and appurtenances in violation to be removed and replaced at the owners expense.

The Fall Creek Regional Waste District is responsible for the inspection, approval of materials, and installation techniques only. All costs for materials and installation and any liabilities resulting from same is the sole responsibility of the property owner.

I have read and fully understand the above provisions and agree to comply by said provisions.

APPLICANT(S) SIGNATURE

9-8-99

INSPECTOR

TIM Dow

Date inspected

8-20-99

Approved

Rejected

Reason for rejection

Date reinspected

Approved

Rejected

Notes:

Size Pipe

4"

Type Pipe

Sch. 40

Basement Yes

✓ No

Sump Pump Yes

No ✓

Downspout to Ground Yes

✓ No

Septic Tank Pumped & filled Yes

No

Contractor

NED CRAIG

Special Conditions

Glue Joints

(PARTIAL INSPECTION)


Existing Home

New Construction

✓

Consider unit is not set yet. ↑ North

ELEC LINE

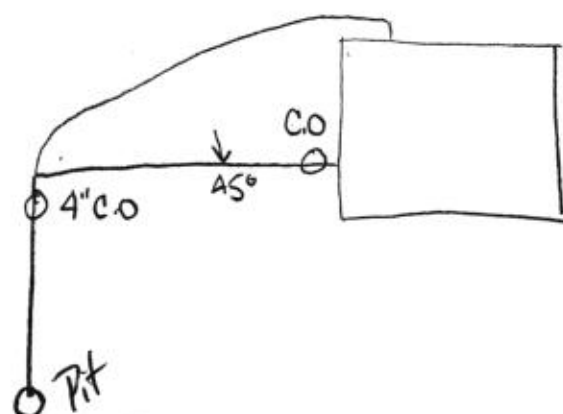

GTE

S.R. 38

Set Pit 24" Below Crane
To Be Cut Down To Crane

STEPHEN E. BOURKE
 6471 S. FOX CHASE
 PENDLETON, IN 46064

20-174
 740
 700001463772
 DATE May 28, 2000

2230

PAY TO THE ORDER OF Fall Creek Regional Waste District \$ 2556.00
Two-thousand-five-hundred-fifty-six and 00/100 DOLLARS

BANK ONE.
 Bank One, Indiana, NA
 Indianapolis, IN 46277

MEMO _____

Stephen R. Bourke

10740000101 700001463772 2230

PRESCRIBED BY STATE BOARD OF ACCOUNTS

GENERAL FORM NO. 382

RECEIPT
 FALL CREEK REGIONAL WASTE DISTRICT
 P.O. BOX 59, CO. RD. 650 WEST

No 6568

gen FUND

PENDLETON, IN. 46064, 6/2 19 2000

RECEIVED FROM Stephen R. Bourke \$ 2556.00

THE SUM OF Two thousand five hundred fifty six & 00/100 DOLLARS

ON ACCOUNT OF tap & Capacity fee
6471 S Fox Chase

PAID BY: CASH ☐ CHECK ☒ M.O. ☐

Libbie Wilson
 AUTHORIZED SIGNATURE