

G.R.W.

PROJECT Phase II SHEET _____ OF _____


SUBJECT _____ DATE 6-15-18

JOB NO. 4447

BY Atlas

647 S. Pendleton

← N

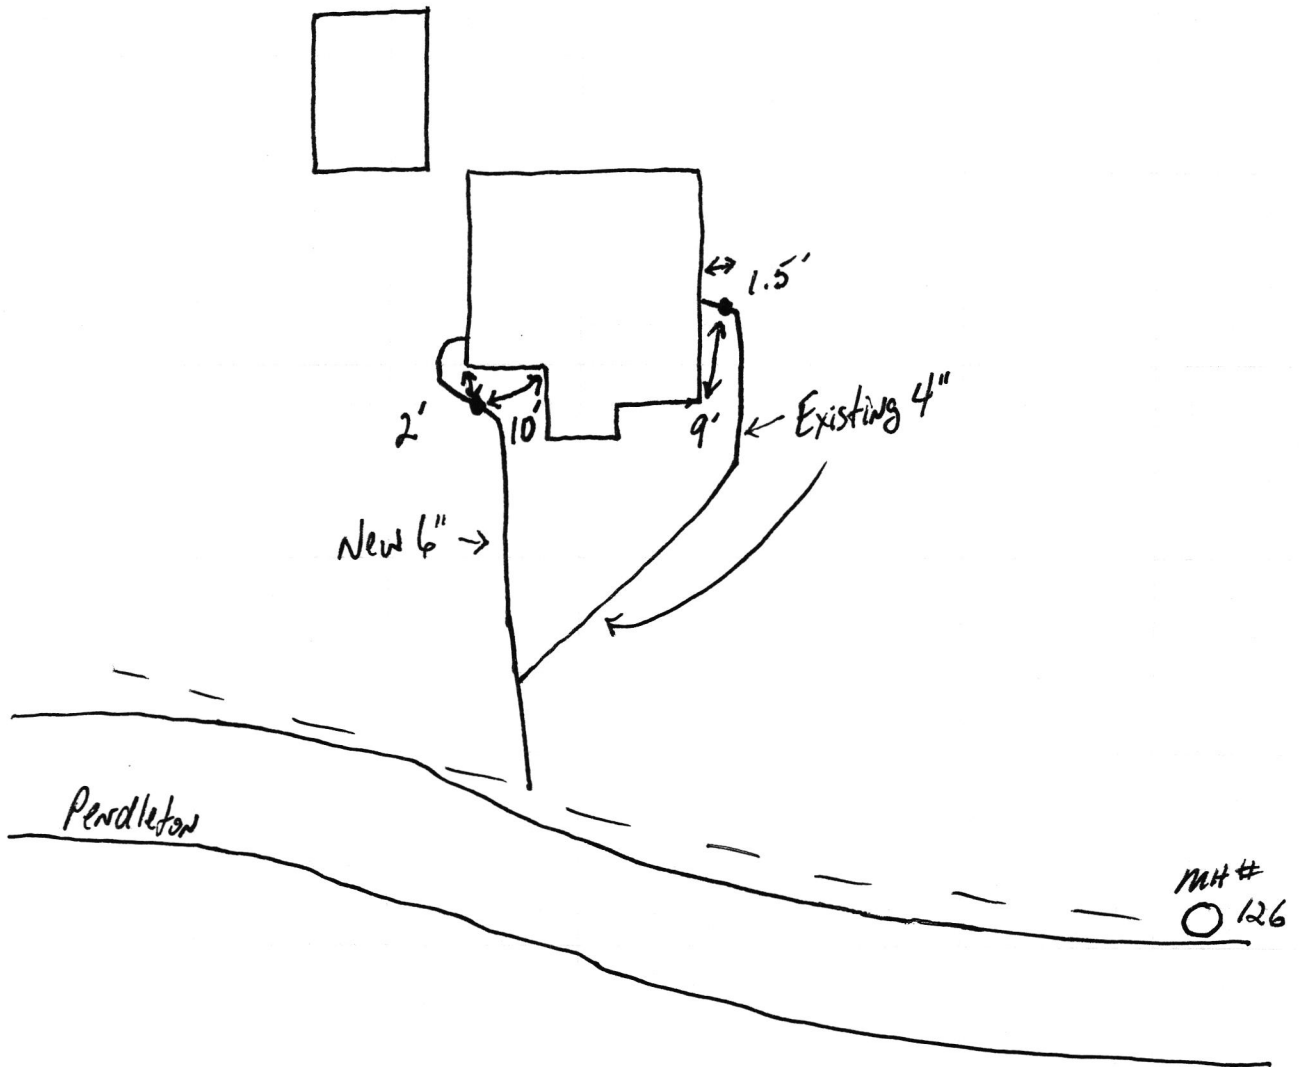

447 S Rendition Ave

SRF Phase II

10.19.18



447 S Pendleton Ave

SRE Phase II

6.19.18

