

№ 5908

9378 S 650 WEST, P.O. BOX 59, PENDLETON, IN 46064  
765-778-7544

## AGREEMENT FOR SANITARY SEWER SERVICE

This Agreement made and entered into this 2 day of January, 2006, between FALL CREEK REGIONAL WASTE DISTRICT ("District") and Link, Tony & Joanne ("Applicant") regarding the provision of sanitary sewer service, and the assignment of capacity in, and connection to, the District's facilities for the premises located at Tetterton Place lot 45, 1121 W. Monroe

**NOW THEREFORE**, the parties, in consideration of the mutual promises set out in this Agreement, the receipt and sufficiency of which is hereby acknowledged, agree as follows:

1. The Applicant agrees that all workmanship and materials shall conform to all District ordinances and the District's construction standards. District must accept and approve all work and materials before backfilling and final connection is made to the sewer mains. Any violation of this provision will cause all lines and appurtenances in violation to be removed and replaced at the Applicant's expense.
2. The District shall have the right to enter upon the Applicant's premises at all reasonable times to inspect, repair, or replace any equipment used in connection with the District's service or which has an impact on said service.
3. The Applicant shall be responsible for all monthly user rates, capacity charges, and tap fees. The failure to pay any rate charge or fee may result in a lien against the property and/or the termination of service to the property, the cost of which will be borne by Applicant, including, but not limited to, all attorney's fees and collection costs.
4. The District shall not be responsible for any damages as a result of any failure to supply service unless said damages are due to default, neglect or culpability on the part of the District.
5. If there is an available sanitary sewer within three hundred (300) feet of the property line, the property owner shall be required to connect to the District's sanitary sewer system.
6. The Applicant and District agree that the provision of sanitary sewer service touches and concerns the property and the terms of this Agreement bind the District and Applicant and their heirs, executors, administrators, personal representatives, successors, agents, attorneys, assigns, designees, and transferees.

FALL CREEK REGIONAL WASTE DISTRICT  
Debbie Wilson  
Signature

APPLICANT  
Kathy C. Hollaway  
Signature

[illegible]

SUBSCRIBED and sworn to before me this 31<sup>st</sup> day of January, 2006

My Commission Expires: 2-20-2008

Signature Deborah L. Wilson  
Printed Deborah L. Wilson

**Notary Public**  
**Resident of Madison County**

INSPECTOR 24 DATE INSPECTED 3-1-06 APPROVED ☒ REJECTED

REASON FOR REJECTION

DATE REINSPECTED	APPROVED	REJECTED
------------------	----------	----------

NOTES:  
SIZE PIPE 6" TYPE PIPE SDR35

BASEMENT YES ☒ NO

SUMP PUMP YES        NO Y

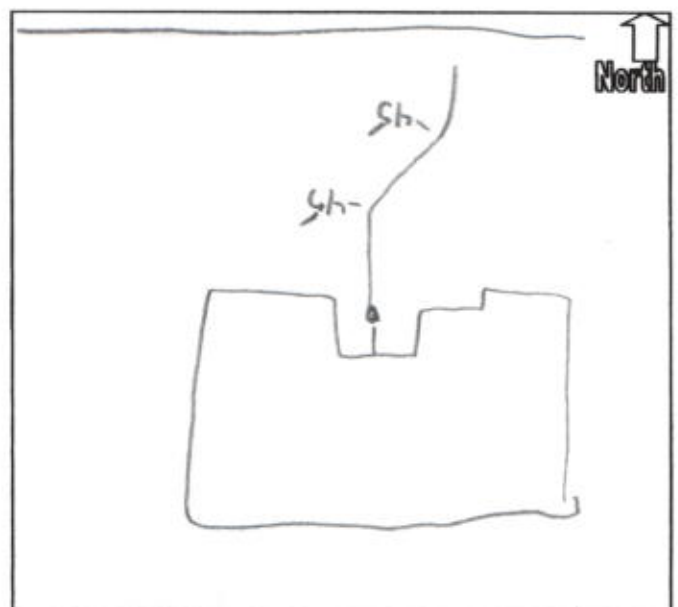
DOWNSPOUT TO GROUND YES NO ☒

SEPTIC TANK PUMPED &amp; FILLED YES NO

CONTRACTOR Lowy & Koffel

### SPECIAL CONDITIONS

## EXISTING HOME

NEW CONSTRUCTION X

ROD HOLLOWAY HOMES, INC.

765-778-8291  
325 E. 1000 S.  
PENDLETON, IN 46064

NATIONAL CITY BANK  
INDIANAPOLIS, IN 46256  
20-6/740

1945

1-3-06

PAY TO THE  
ORDER OF

Fall Creek Regional Waste District

\$ 2635.00

Two thousand six hundred thirty-five and  $\frac{0}{100}$  DOLLARS

MEMO

Roddy C. Holloway <sup>MP</sup>  
AUTHORIZED SIGNATURE

⑈001945⑈ ⑆074000065⑆ 501905552⑈