

add order
on file



FALL CREEK REGIONAL WASTE DISTRICT

9378 S. 650 West PO Box 59
Pendleton, IN 46064-0059 778-7544

26-10100.00

APPLICATION FOR SEWER PERMIT

Nº 2701

Date

8/30/99

Permit Void 90 days from Date of Issuance

Owner Name

Hong Zhang

Property Address

6482 S Fox Chase

Lot #

12, Fox Run

P.O. Box

Town

Pendleton

, IN

Zip Code

46064

Phone

778-0767

City Water

Well

✓

\$ ~~255.6~~ 2556.00

Tap on Fee Paid

400" tap

2156" capacity

pd 4/28/00

\$

Inspection fee paid

Application is hereby made for connection to the Fall Creek Regional Waste District Sewer System for the above listed property - Permit Type: Residential ☒, Commercial ☐, Industrial ☐, or Governmental/Institutional ☐. User Information

All workmanship and materials shall conform to the standards of the District Ordinance as described in Ordinance 84-2 and 84-3 as amended. Acceptance and approval must be made by the District inspector or his duly authorized representative before backfilling and final connection is made to the main sewer lines. Any violation of applicable regulations will cause all lines and appurtenances in violation to be removed and replaced at the owners expense.

The Fall Creek Regional Waste District is responsible for the inspection, approval of materials, and installation techniques only. All costs for materials and installation and any liabilities resulting from same is the sole responsibility of the property owner.

I have read and fully understand the above provisions and agree to comply by said provisions.

Hong Zhang

APPLICANT(S) SIGNATURE

INSPECTOR

Tim

Date inspected 8-20-99

Approved

Rejected

Reason for rejection

Date reinspected

Approved

Rejected

Notes:

Size Pipe 4" "

Type Pipe Sch. 40

Basement Yes No ✓

Sump Pump Yes No ✓

Downspout to Ground Yes/ No


Septic Tank Pumped & filled Yes No

Contractor NEO Craig

Special Conditions

Existing Home

New Construction ✓

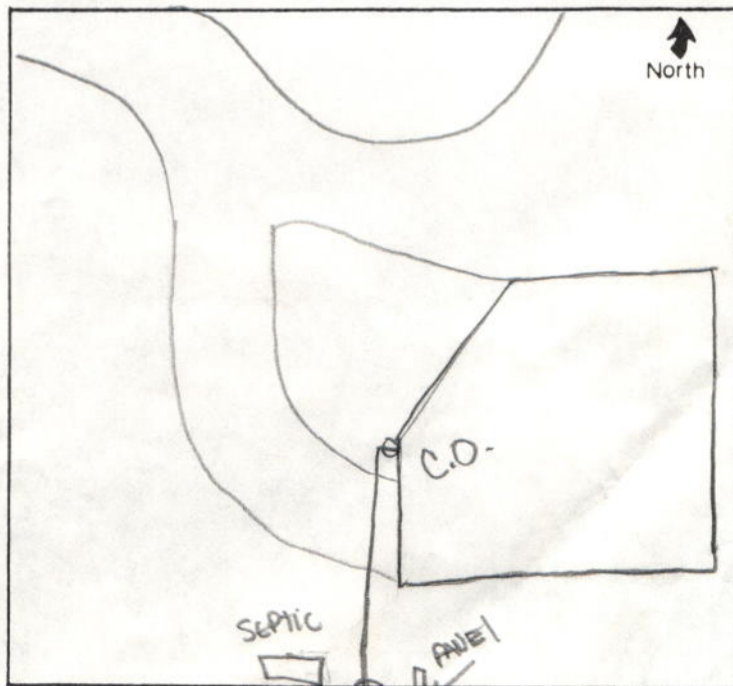

addition
to file

FALL CREEK REGIONAL WASTE DISTRICT

1111 E. 450 West, P.O. Box 77
Bend, Oregon 97701-0077



SA-10100-00

NO-2701

APPLICATION FOR LICENSE

1/30/99

DATE

Permit valid 90 days from date of issuance

Owner Name Mr. & Mrs. J. R. Kuy

Property Address Unit 2, Box 100

City, State, Zip Portland, OR 97201

Phone 503-255-0000

Permit 778-0000

Permit 778-0000

