8-19-188.00


#7751


Fall Creek Regional Waste District 9378 S 650 W, P.O. Box 59, Pendleton, IN 46064 765-778-7544

Agreement for Sanitary Sewer Service

This Agreement made and entered into this day of Mrch, 2020, between Fall Creek Regional Waste District ("District") and	
Street Address: 650 Blarney DR, Pendlodon	
Now therefore, the parties, in consideration of the mutual promises set out in this Agreement, the receipt and sufficiency of which is hereby acknowledged, agree as follows:	
 The Applicant agrees that all workmanship and materials shall conform to all District ordinances and the District's construction standards. District must accept and approve all work and materials before backfilling and final connection is made to the sewer mains. Any violation of this provision will cause all lines and appurtenances in violation to be removed and replaced at the Applicant's expense. The District shall have the right to enter upon the Applicant's premises at all reasonable times to inspect, repair, or replace any equipment used in connection with the District's service or which has an impact on said service. The Applicant shall be responsible for all monthly user rates, capacity charges, and tap fees. The failure to pay any rate charge or fee may result in a lien against the property and/or the termination of service to the property, the cost of which will be borne by Applicant, including, but not limited to, all attorney's fees and collection costs. The District shall not be responsible for any damages as a result of any failure to supply service unless said damages are due to default, neglect or culpability on the part of the District. If there is an available sanitary sewer within three hundred (300) feet of the property line, the property owner shall be required to connect to the District's sanitary sewer system. The Applicant and District agree that the provision of sanitary sewer service touches and concerns the property and the terms of this Agreement bind the District and Applicant and their heirs, executors, administrators, personal representatives, successors, agents, attorneys, assigns, designees, and transferees. 	
The parties hereto have read and fully understand the above provisions and agree to comply with said provisions.	
FALL CREEK REGIONAL WASTE DISTRICT Signature	APPLICANT
STATE OF INDIANA)	
) SS: COUNTY OF MADISON)	
SUBSCRIBED and sworn to before me this day of, 20	
My Commission Expires: Signature	
Printed Notary Public Resident of County	

Inspector Lyle Date Inspected 12/8/23 Approved Rejected Reason for Rejecton	
Notes: Date Reinspected Approved	Rejected
Size Pipe Type Pipe 35 Basement Yes No Sump Pump Yes No Downspout to Ground Yes No Septic Tank Pumped & Filled Yes No Contractor \(\(\) \	North
Existing Home New Construction	1 picture attached

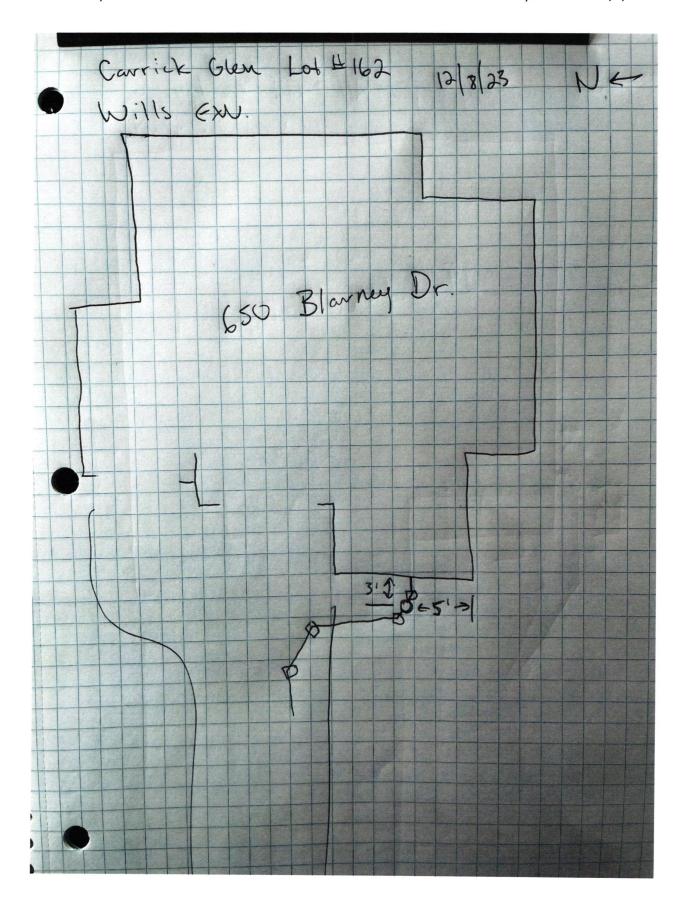

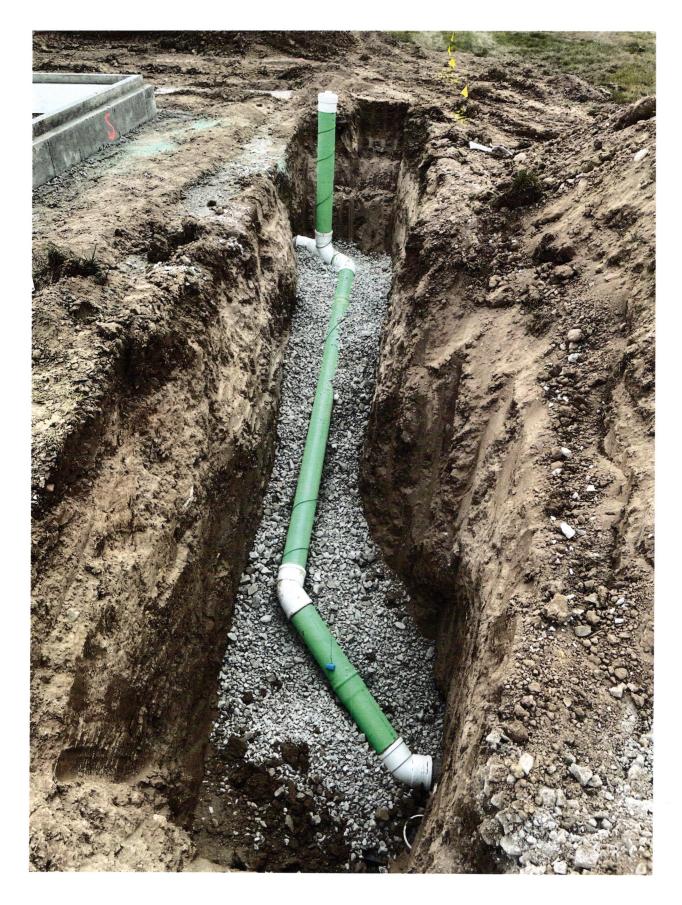

THIS CHECK IS PRINTED IN RED AND BLUE INK ON THE FACE ON CHEMICAL AND BLEACH REACTIVE PAPER WITH INVISIBLE FLUORESCENT FIBERS AND BASKETWEAVE ON BACK

IND. HURTING. SHE

IN A PROPERTY Chees Park, N. A.

Check Number 1471003

NRHORTON Builder

Controlled Disb
1341 Horton Circle

Arlington, TX 76011

JP Morgan Chase Bank, N.A. Syracuse, NY

50-937

Date Amount
03/16/22 \$******760.00

2720128

Void after 6 months from date of issue

SEVEN HUNDRED SIXTY AND 00/100 ***

Pay To The Order Of: FALL CREEK REGIONAL WASTE DISTRICT 9378 SOUTH 650 WEST PENDLETON IN 46064

D. L. Hocton

C6162

012170