



# FALL CREEK REGIONAL WASTE DISTRICT

9378 S. 650 West PO Box 59  
Pendleton, IN 46064-0059 778-7544

23-01620.00

Nº 2566

## APPLICATION FOR SEWER PERMIT

Permit Void 90 days from Date of Issuance  
Date 8/07/98  
Owner Name Ronald H. Acom  
Property Address 6540 80th St #67  
Lot # Pendleton P.O. Box   
Town Pendleton IN Zip Code 46064  
Phone 765/778-2729 City Water  Well X  
\$ X Tap on Fee Paid  
\$ X Inspection fee paid

Application is hereby made for connection to the Fall Creek Regional Waste District Sewer System for the above listed property - Permit Type: Residential X, Commercial , Industrial , or Governmental/Institutional . User Information .

All workmanship and materials shall conform to the standards of the District Ordinance as described in Ordinance 84-2 and 84-3 as amended. Acceptance and approval must be made by the District inspector or his duly authorized representative before backfilling and final connection is made to the main sewer lines. Any violation of applicable regulations will cause all lines and appurtenances in violation to be removed and replaced at the owners expense.

The Fall Creek Regional Waste District is responsible for the inspection, approval of materials, and installation techniques only. All costs for materials and installation and any liabilities resulting from same is the sole responsibility of the property owner.


I have read and fully understand the above provisions and agree to comply by said provisions.

Ronald H. Acom  
APPLICANT(S) SIGNATURE

INSPECTOR B  
Date inspected 8-8-98 Approved X Rejected   
Reason for rejection

Date reinspected  Approved  Rejected

Notes:  
Size Pipe 6 "  
Type Pipe PVC  
Basement Yes X No   
Sump Pump Yes X No   
Downspout to Ground Yes X No   
Septic Tank Pumped & filled Yes X No   
Contractor M & M  
Special Conditions   
Existing Home   
New Construction

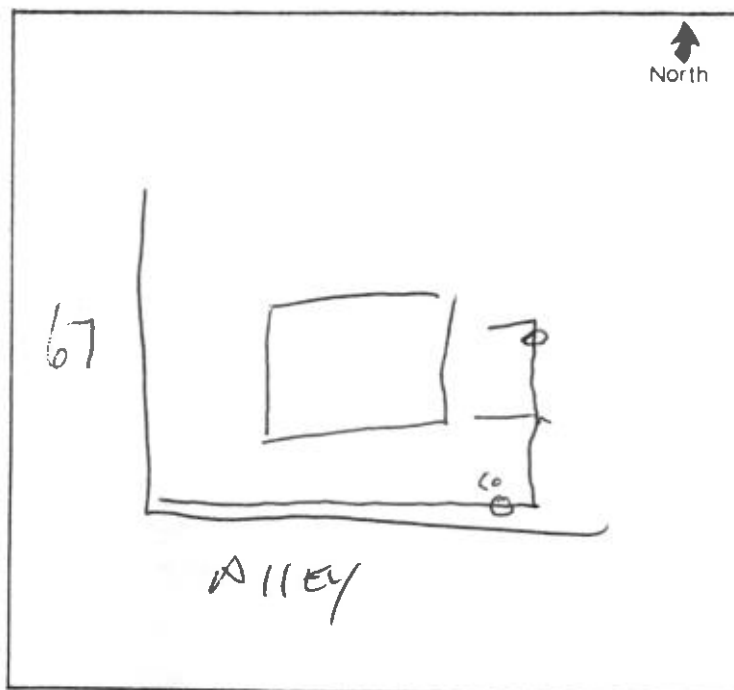

CHICAGO, ILL.

1925

AD 1/10

12/10/25

X 1/10

12/10/25

X

12/10/25

X

12/10/25

12/10/25

12/10/25



12/10/25