



FALL CREEK REGIONAL WASTE DISTRICT

9378 S. 650 West PO Box 59
Pendleton, IN 46064-0059 778-7544

APPLICATION FOR SEWER PERMIT

Nº 2540

Date 7/28/98

Permit Void 90 days from Date of Issuance

Owner Name Mary McQuade

Property Address 6550 S SR 67

Lot # _____ P.O. Box _____

Town Pendleton, IN Zip Code 46064

Phone _____ City Water _____ Well ☒

\$ N/A Tap on Fee Paid

\$ N/A Inspection fee paid

Application is hereby made for connection to the Fall Creek Regional Waste District Sewer System for the above listed property - Permit Type: Residential ☒, Commercial _____, Industrial _____, or Governmental/Institutional _____. User Information _____.

All workmanship and materials shall conform to the standards of the District Ordinance as described in Ordinance 84-2 and 84-3 as amended. Acceptance and approval must be made by the District inspector or his duly authorized representative before backfilling and final connection is made to the main sewer lines. Any violation of applicable regulations will cause all lines and appurtenances in violation to be removed and replaced at the owners expense.

The Fall Creek Regional Waste District is responsible for the inspection, approval of materials, and installation techniques only. All costs for materials and installation and any liabilities resulting from same is the sole responsibility of the property owner.

I have read and fully understand the above provisions and agree to comply by said provisions.

Mary E. McQuade
APPLICANT(S) SIGNATURE

INSPECTOR B

Date inspected 4-19-99 Approved ☒ Rejected _____

Reason for rejection _____

Date reinspected _____ Approved _____ Rejected _____

Notes:

Size Pipe 6" 160'

Type Pipe Pvc c60

Basement Yes _____ No ☒

Sump Pump Yes _____ No ☒

Downspout to Ground Yes ☒ No _____


Septic Tank Pumped & filled Yes _____ No ☒

Contractor Godberg

Special Conditions ✓

Existing Home ☒

New Construction _____

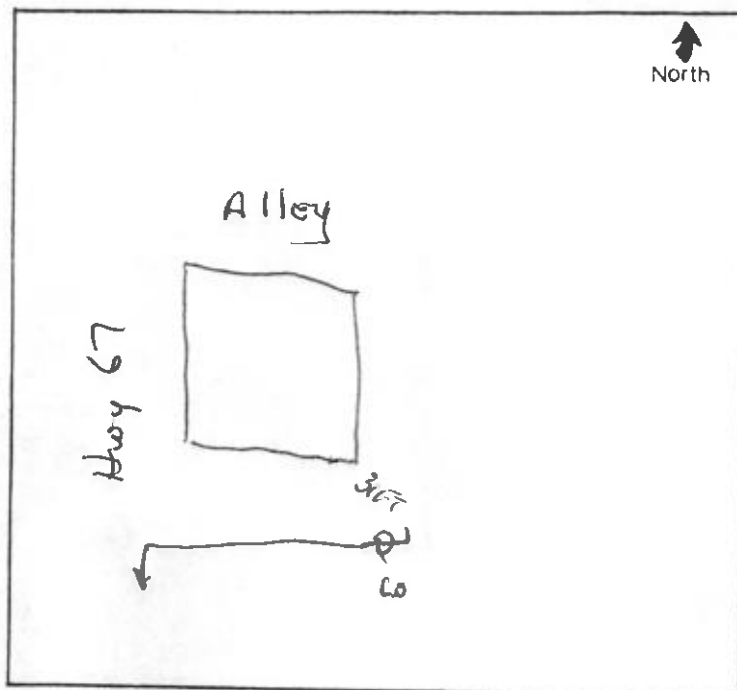

FALL CREEK REGIONAL WASTE DISTRICT

1000 E. 920 West, P.O. Box 20
 Pocatello, ID 83201-0020
 (208) 243-7344



IN 2240

APPLICATION FOR WASTE TREATMENT

1/21/97

Date

Permit valid 90 days from date of issuance

Owner Name

Mark McQuade

Property Address

6220 S 24th

City, State, Zip

Pocatello, ID 83201

Permit Number

City Water

Top of Tank

11/1

Inspected/Flow

11/1

Application is hereby made for connection to the Fall Creek Regional Waste District sewer system for the above listed property - permit type: ☒ Residential ☐ Commercial ☐ Industrial ☐ Other: _____

Applicant agrees and warrants that all information furnished on this application is true and correct to the best of their knowledge and belief. Applicant understands that the Fall Creek Regional Waste District is not responsible for the design, construction, or operation of the sewer system. Applicant agrees to pay all costs associated with the design, construction, and operation of the sewer system. Applicant agrees to maintain the sewer system in good working order and to replace any damaged or defective components at their own expense. Applicant agrees to comply with all applicable laws, regulations, and codes of the Fall Creek Regional Waste District.

The Fall Creek Regional Waste District is responsible for the inspection, approval, and construction of the sewer system. All costs for materials and construction are the responsibility of the property owner. The Fall Creek Regional Waste District is not responsible for the design, construction, or operation of the sewer system.

I have read and fully understand the above provisions and agree to comply with all provisions.

Mark McQuade

Signature of Owner

Inspector

Signature of Inspector

Signature of Inspector


Signature of Inspector

Signature of Inspector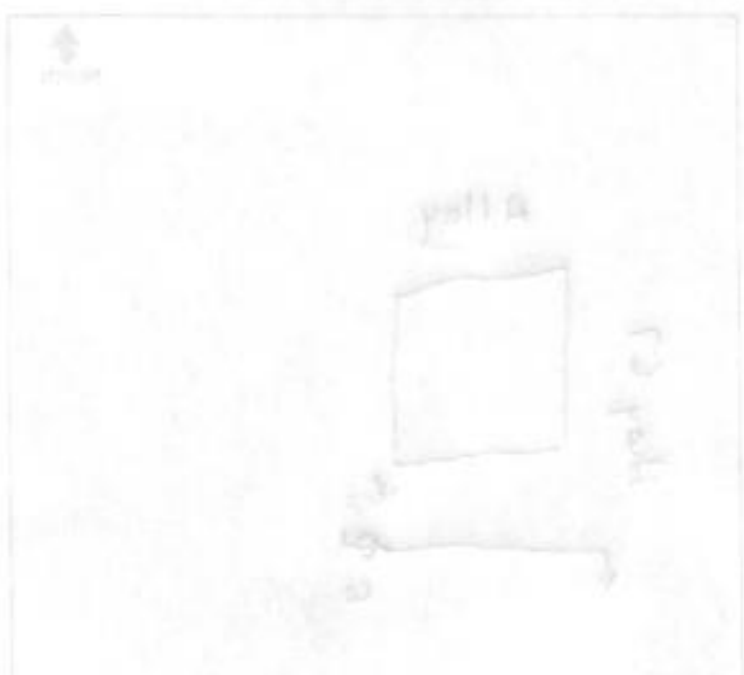

Notes: 1. The property owner has agreed to pay for the design, construction, and operation of the sewer system. 2. The property owner has agreed to maintain the sewer system in good working order and to replace any damaged or defective components at their own expense. 3. The property owner has agreed to comply with all applicable laws, regulations, and codes of the Fall Creek Regional Waste District.