

26-09260.00  
№ 5619

# FALL CREEK REGIONAL WASTE DISTRICT

9378 S 650 WEST, P.O. BOX 59, PENDLETON, IN 46064

765-778-7544

## AGREEMENT FOR SANITARY SEWER SERVICE

This Agreement made and entered into this 12<sup>th</sup> day of July, 2005, between FALL CREEK REGIONAL WASTE DISTRICT ("District") and Eric Bates ("Applicant") regarding the provision of sanitary sewer service, and the assignment of capacity in, and connection to, the District's facilities for the premises located at Tetterton Place lot 50.

**NOW THEREFORE**, the parties, in consideration of the mutual promises set out in this Agreement, the receipt and sufficiency of which is hereby acknowledged, agree as follows:

1. The Applicant agrees that all workmanship and materials shall conform to all District ordinances and the District's construction standards. District must accept and approve all work and materials before backfilling and final connection is made to the sewer mains. Any violation of this provision will cause all lines and appurtenances in violation to be removed and replaced at the Applicant's expense.
2. The District shall have the right to enter upon the Applicant's premises at all reasonable times to inspect, repair, or replace any equipment used in connection with the District's service or which has an impact on said service.
3. The Applicant shall be responsible for all monthly user rates, capacity charges, and tap fees. The failure to pay any rate charge or fee may result in a lien against the property and/or the termination of service to the property, the cost of which will be borne by Applicant, including, but not limited to, all attorney's fees and collection costs.
4. The District shall not be responsible for any damages as a result of any failure to supply service unless said damages are due to default, neglect or culpability on the part of the District.
5. If there is an available sanitary sewer within three hundred (300) feet of the property line, the property owner shall be required to connect to the District's sanitary sewer system.
6. The Applicant and District agree that the provision of sanitary sewer service touches and concerns the property and the terms of this Agreement bind the District and Applicant and their heirs, executors, administrators, personal representatives, successors, agents, attorneys, assigns, designees, and transferees.

The parties hereto have read and fully understand the above provisions and agree to comply with said provisions.

FALL CREEK REGIONAL WASTE DISTRICT  
*Alvin Wilson*  
Signature

APPLICANT  
Signature

STATE OF INDIANA )  
COUNTY OF MADISON) SS:

SUBSCRIBED and sworn to before me this 1<sup>st</sup> day of July, 2008

My Commission Expires: 2-20-2008

Signature Deborah L. Wilson  
Printed Deborah L. Wilson

**Notary Public**  
**Resident of Madison County**

\*\*\*\*\*  
INSPECTOR Don DATE INSPECTED 9-21-05 APPROVED \_\_\_\_\_ REJECTED \_\_\_\_\_

REASON FOR REJECTION

DATE REINSPECTED	APPROVED	REJECTED
------------------	----------	----------

NOTES: 6" TYPE PIPE 35

BASEMENT YES NO       

SUMP PUMP YES NO ☒

DOWNSPOUT TO GROUND YES / NO


SEPTIC TANK PUMPED & FILLED YES ✓ NO

CONTRACTOR ~~HELLER~~ HELLER EXC.

SPECIAL CONDITIONS

## EXISTING HOME

NEW CONSTRUCTION ✓

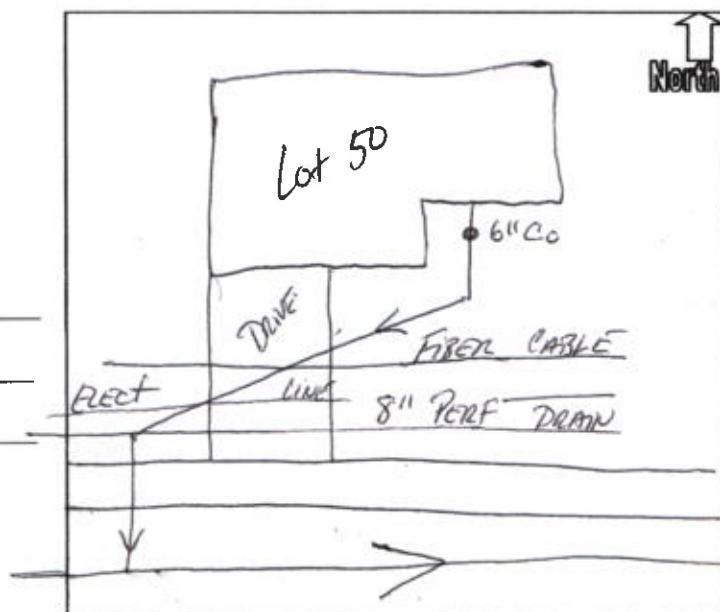



GRIZZLY BEAR

ERIC BATES  
157 SHAMROCK CIR. APT. 1  
Pearl River TN 38664

Date July 1, 2005

71-1/863

PAY TO THE  
ORDER OF

FCRWD

\$ 2635<sup>00</sup>

Two Thousand six hundred thirty-five and 00/100 Dollars



Security features  
are included.  
Details on back.



OLD NATIONAL BANK  
Evansville, Indiana | www.oldnational.com

For SEWER PERMIT

E. Bates

MP

⑆086300012⑆ 120799991⑆

©Clarke American

WILDLIFE PORTRAITS® WWF