


#6780

This Agreement made and entered into this 10 day of Dec, 2018, between Fall Creek Regional Waste District ("District") and Archer Homes ("Applicant") regarding the provision of sanitary sewer service, and the assignment of capacity in and connection to, the District's facilities for the premises located at Lot # 40

A blank map template with a north arrow in the top right corner. The north arrow is a simple line drawing of an arrow pointing upwards, with the word "North" written to its left. The rest of the map area is empty, with only faint, light gray lines suggesting a grid or coastline.

# Maple Trails

FORM 3310 8-4-03

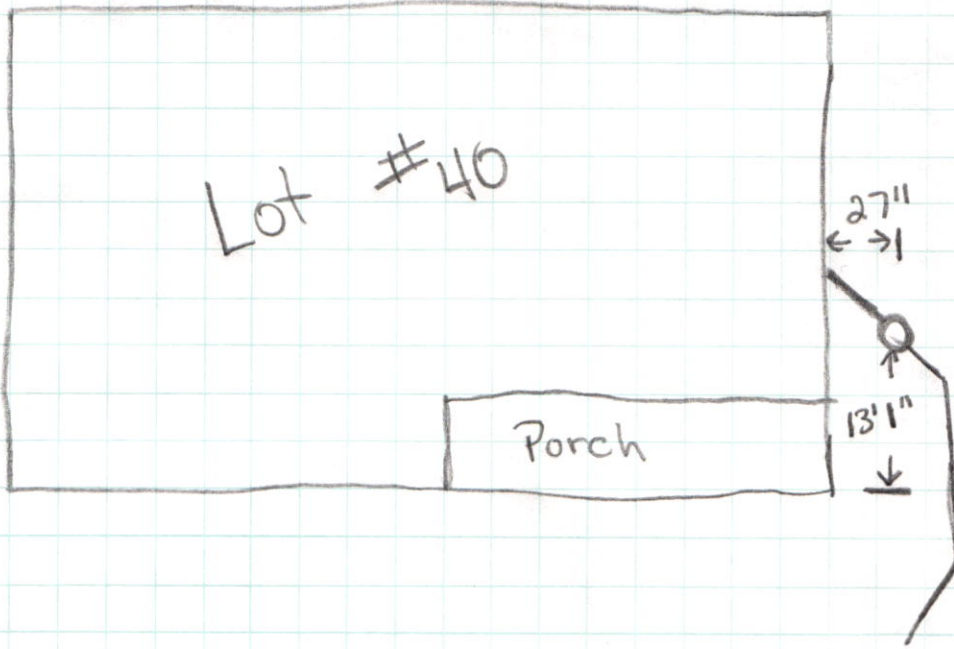



6542 Laurel Wood Dr

Maple Trails Lot 40

Kyle Cravens 4-10-19





10562 Laurel Wood Dr

Maple Trails Lot 40

Kyle Crawens

4-10-19





6562 Laurel wood Dr Maple Trails lot 40

Kyle Crawens 4.10.19

