



FALL CREEK REGIONAL WASTE DISTRICT

9378 S. 650 West PO Box 59  
Pendleton, IN 46064-0059 778-7544

26-09070.00

add order  
on file

Contractor: Jerry Fredericks

Nº 2774

APPLICATION FOR SEWER PERMIT

Date 5/10/00

Permit Void 90 days from Date of Issuance

Owner Name Vern George

Property Address 6564 W Congress Dr.

Lot # 12, Jefferson Place P.O. Box \_\_\_\_\_

Town Pendleton IN Zip Code 46064

Phone \_\_\_\_\_ City Water \_\_\_\_\_ Well ☒

\$ 400.00 Tap on Fee Paid

\$ 2156.00 capacity inspection fee paid

Application is hereby made for connection to the Fall Creek Regional Waste District Sewer System for the above listed property - Permit Type: Residential ☒, Commercial \_\_\_\_\_, Industrial \_\_\_\_\_, or Governmental/Institutional \_\_\_\_\_. User Information \_\_\_\_\_.

All workmanship and materials shall conform to the standards of the District Ordinance as described in Ordinance 84-2 and 84-3 as amended. Acceptance and approval must be made by the District inspector or his duly authorized representative before backfilling and final connection is made to the main sewer lines. Any violation of applicable regulations will cause all lines and appurtenances in violation to be removed and replaced at the owners expense.

The Fall Creek Regional Waste District is responsible for the inspection, approval of materials, and installation techniques only. All costs for materials and installation and any liabilities resulting from same is the sole responsibility of the property owner.

I have read and fully understand the above provisions and agree to comply by said provisions.

Vern N. George  
APPLICANT(S) SIGNATURE

\*\*\*\*\*

INSPECTOR [Signature]

Date inspected 5-16-00 Approved ☒ Rejected \_\_\_\_\_

Reason for rejection \_\_\_\_\_

Date reinspected \_\_\_\_\_ Approved \_\_\_\_\_ Rejected \_\_\_\_\_

Notes:

Size Pipe 6"

Type Pipe PVC 35

Basement Yes \_\_\_\_\_ No ☒

Sump Pump Yes \_\_\_\_\_ No ☒

Downspout to Ground Yes ☒ No \_\_\_\_\_


Septic Tank Pumped & Filled Yes ☒ No \_\_\_\_\_

Contractor Jerry Fredericks

Special Conditions 4th P.O.

Existing Home ☒

New Construction \_\_\_\_\_

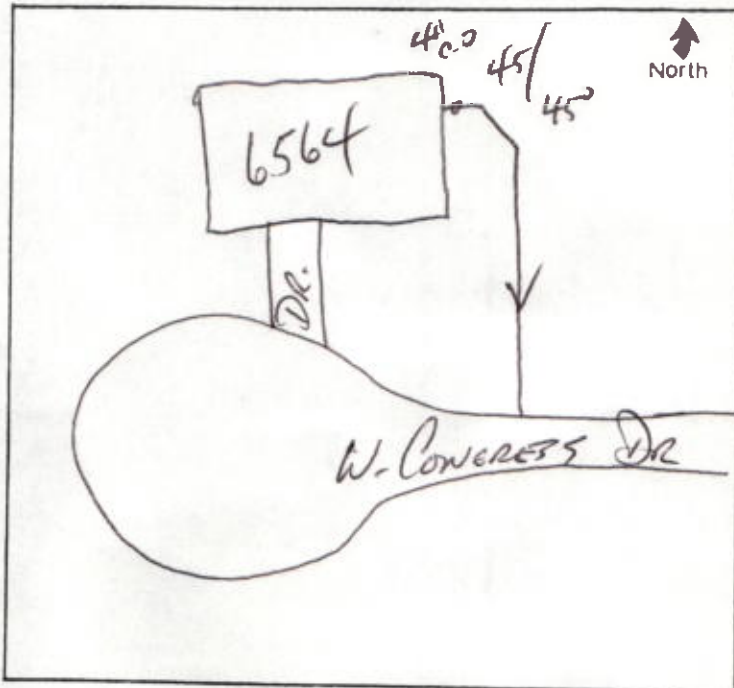

with water  
coffee

PALL CREEK REGIONAL WASTE DISTRICT  
3078 S. 45th WEST, BOX 22  
EDMONTON, TX 76844-0022 214-734-1144



Customer Survey Questionnaire

No 277A

INSTRUCTIONS FOR NEW SERVICE

Date 2/10/90

Service type WATER

Service area 16th Street

Service address 16th St & Congress St

Service meter 16th St

Service meter number 16th St

Service meter size 1/2"

Service meter type 1/2"

Service meter material 1/2"

Service meter location 1/2"

Service meter condition 1/2"

Service meter notes 1/2"

Application for service is hereby made for connection to the Pall Creek Regional Waste District. The applicant agrees to pay the service fee and to maintain the service in good condition. The applicant also agrees to pay the service fee and to maintain the service in good condition. The applicant also agrees to pay the service fee and to maintain the service in good condition.

The Pall Creek Regional Waste District is responsible for the collection, transport, and disposal of solid waste. The applicant agrees to pay the service fee and to maintain the service in good condition. The applicant also agrees to pay the service fee and to maintain the service in good condition.

I have read and understand the above provisions and agree to comply with them.

*[Signature]*

DATE OF SERVICE 2/10/90

DATE OF BILLING 2/10/90

DATE OF PAYMENT 2/10/90

DATE OF COLLECTION 2/10/90

DATE OF DISPOSAL 2/10/90

DATE OF RECYCLING 2/10/90

DATE OF INCINERATION 2/10/90

DATE OF LANDFILL 2/10/90

DATE OF COMPOSTING 2/10/90

DATE OF OTHER 2/10/90

DATE OF TOTAL 2/10/90

DATE OF TOTAL 2/10/90


DATE OF TOTAL 2/10/90

DATE OF TOTAL 2/10/90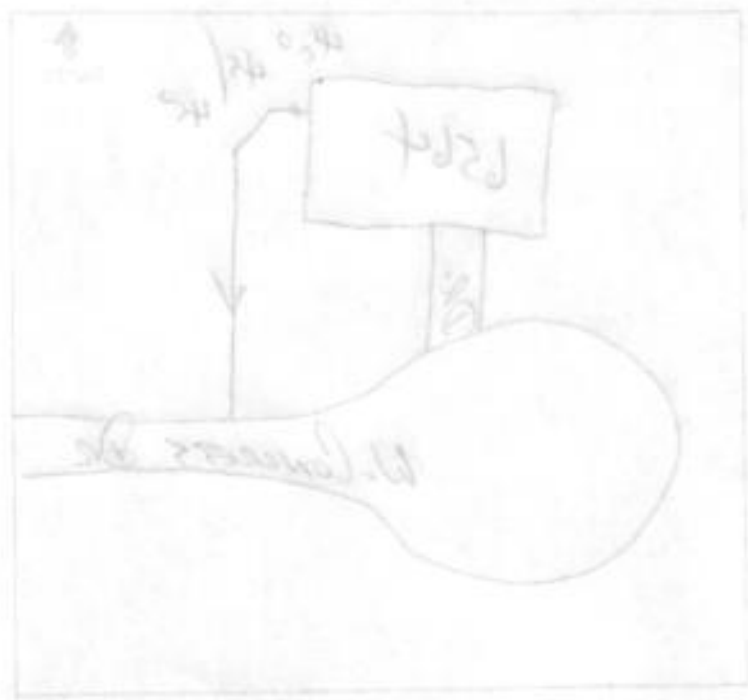

9378 S. CR 650 W.  
P.O. Box 59  
Pendleton, IN 46064  
Phone: 765-778-7544

**INVOICE**

Name	Vern George	Acct #		Project Area #	D
Address	6564 W Congress Dr			W.O. #	9915
City	Pendleton	State	IN	Zip	46064
Phone				Due Date	90 days

QTY	DESCRIPTION	UNIT PRICE	TOTAL
1	tap fee	\$400.00	\$400.00
1	capacity fee	\$2,156.00	\$2,156.00
		<b>Sub-Total</b>	\$2,556.00

DATE	PAYMENT	CHECK NUMBER	AMOUNT
		<b>Sub-Total</b>	<b>\$0.00</b>

<b>TOTAL</b>	<b>\$2,556.00</b>
--------------	-------------------

*Detach bottom portion and return with payment*

**Cut here**

Customer			
Name	Vern George	Acct #	
Address	6564 W Congress Dr		Project Area # D
City	Pendleton	State IN	W.O. # 9915
Phone		Zip 46064	Due Date 90 days
		0	
			Amount Due \$2,556.00

VERN H. GEORGE  
NANCY E. GEORGE  
6564 W. CONGRESS  
PENDLETON IN 46064  
Account #80000117166461001

GMAC Mortgage  
**EquityLine**  
Home Equity Credit Line

104

60-162/433

Date Nov 10, 2000


Pay to the  
order of

Fall Creek Regional Waste District

\$ 2556<sup>00</sup>/<sub>100</sub>

Two thousand five hundred fifty six and <sup>no</sup>/<sub>100</sub>

Dollars


 Security features  
included.  
Details on back.

Payable Through  
PNC Bank, N.A., Jeannette, PA

NOT VALID FOR LESS THAN \$250.00

For

400 - tap-on  
2156 - capacity

Vern H. George 

⑈016210104⑈ ⑈043301627⑈ ⑈008964327⑈