

add order
on file



FALL CREEK REGIONAL WASTE DISTRICT

9378 S. 650 West PO Box 59
Pendleton, IN 46064-0059 778-7544

26-00410.00

APPLICATION FOR SEWER PERMIT

Nº 2827

Date 6/28/00

Permit Void 90 days from Date of Issuance

Owner Name Mark Wright

Property Address 6584 W SR 38

Lot # _____ P.O. Box _____

Town Pendleton, IN Zip Code 46064

Phone _____ City Water _____ Well ☒

\$ 2556.00 Tap on Fee Paid

\$ N/A Inspection fee paid

Application is hereby made for connection to the Fall Creek Regional Waste District Sewer System for the above listed property - Permit Type: Residential _____, Commercial _____, Industrial _____, or Governmental/Institutional _____. User Information _____.

All workmanship and materials shall conform to the standards of the District Ordinance as described in Ordinance 84-2 and 84-3 as amended. Acceptance and approval must be made by the District inspector or his duly authorized representative before backfilling and final connection is made to the main sewer lines. Any violation of applicable regulations will cause all lines and appurtenances in violation to be removed and replaced at the owners expense.

The Fall Creek Regional Waste District is responsible for the inspection, approval of materials, and installation techniques only. All costs for materials and installation and any liabilities resulting from same is the sole responsibility of the property owner.

I have read and fully understand the above provisions and agree to comply by said provisions.

Shirley J. Elliott
APPLICANT(S) SIGNATURE


INSPECTOR [Signature]
Date inspected 7-7-00 Approved ☒ Rejected _____

Reason for rejection _____

Date reinspected _____ Approved ☒ Rejected _____

Notes:
Size Pipe 6"
Type Pipe DVC 35
Basement Yes ☒ No _____
Sump Pump Yes ☒ No _____
Downspout to Ground Yes ☒ No _____
Septic Tank Pumped & filled Yes ☒ No _____
Contractor Long/Kottler Inc.
Special Conditions _____

Existing Home ☒
New Construction _____

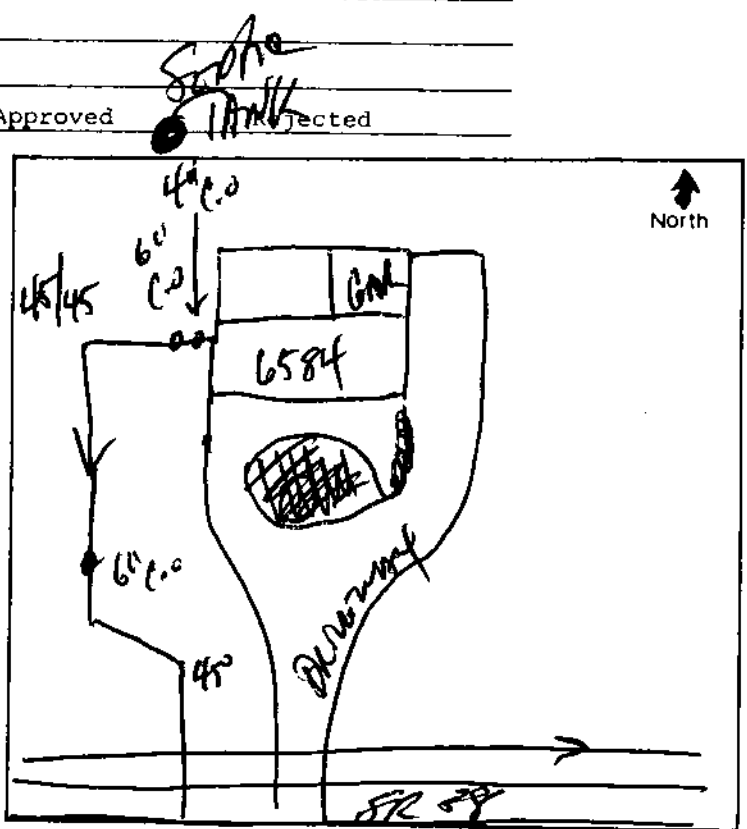

9378 S. CR 650 W.
P.O. Box 59
Pendleton, IN 46064
Phone: 765-778-7544

INVOICE

Name	Mark Wright	Acct #	26-00410.00
Address	6584 W SR 38		
City	Pendleton	State	IN Zip 46064
Phone			

Project Area # D
W.O. # 9915
Due Date 90 days

DATE	PAYMENT	CHECK NUMBER	AMOUNT
		Sub-Total	\$0.00

Detach bottom portion and return with payment

Cut here

Name Mark Wright Acct # 26-00410.00
Address 6584 W SR 38
City Pendleton State IN Zip 46064
Phone _____

Project Area #	D
W.O. #	9915
Due Date	90 days

Amount Due	\$2,556.00
-------------------	-------------------

DAILY SUMMARY

CMD7-END

Account No 260041000 WRIGHT, MARK

6584 W SR 38

Sel	Date	Tran Type	Total	Waste Wtr	Penalty
	3/25/99	BILLING	27.35	27.35	
	4/26/99	BILLING	54.70	54.70	
	5/19/99	BILL ADJ	.41	.41	
	5/26/99	BILLING	82.05	82.05	
	6/25/99	BILLING	109.40	109.40	
	7/26/99	BILLING	136.75	136.75	
	8/27/99	BILLING	164.10	164.10	
	9/24/99	BILLING	191.45	191.45	
	10/25/99	BILLING	218.80	218.80	
	11/24/99	BILLING	246.15	246.15	
	12/23/99	BILLING	273.50	273.50	
	1/24/00	BILLING	300.85	300.85	
	2/17/00	BILL ADJ	4.10	4.10	
	2/25/00	BILLING	328.20	328.20	
	3/24/00	BILLING	355.55	355.55	

Pd 0

Mark W. Wright
Sally J. Wright
6584 W. St. Rd. 38
Pendleton, IN 46064

20-7043/2740

6490

Date June 28, 2000

Pay to the order of ECRWD \$2556.00

Two thousand five hundred fifty-six⁰⁰/₁₀₀ dollars

FIRST INDIANA BANK
INDIANAPOLIS, INDIANA 46204

For Sewer Hook up

Sherry J. Gillett

⑆ 274070439⑆

6490

FOR DEPOSIT ONLY - FIRST INDIANA BANK
TO REQUEST 1-800-561-7147, www.firstindiana.com