



10-29-19


MAPLE TRAILS

6657 CARRETTON

6587 MAY APPLE DR

LOT 83

DR. WATER EX.

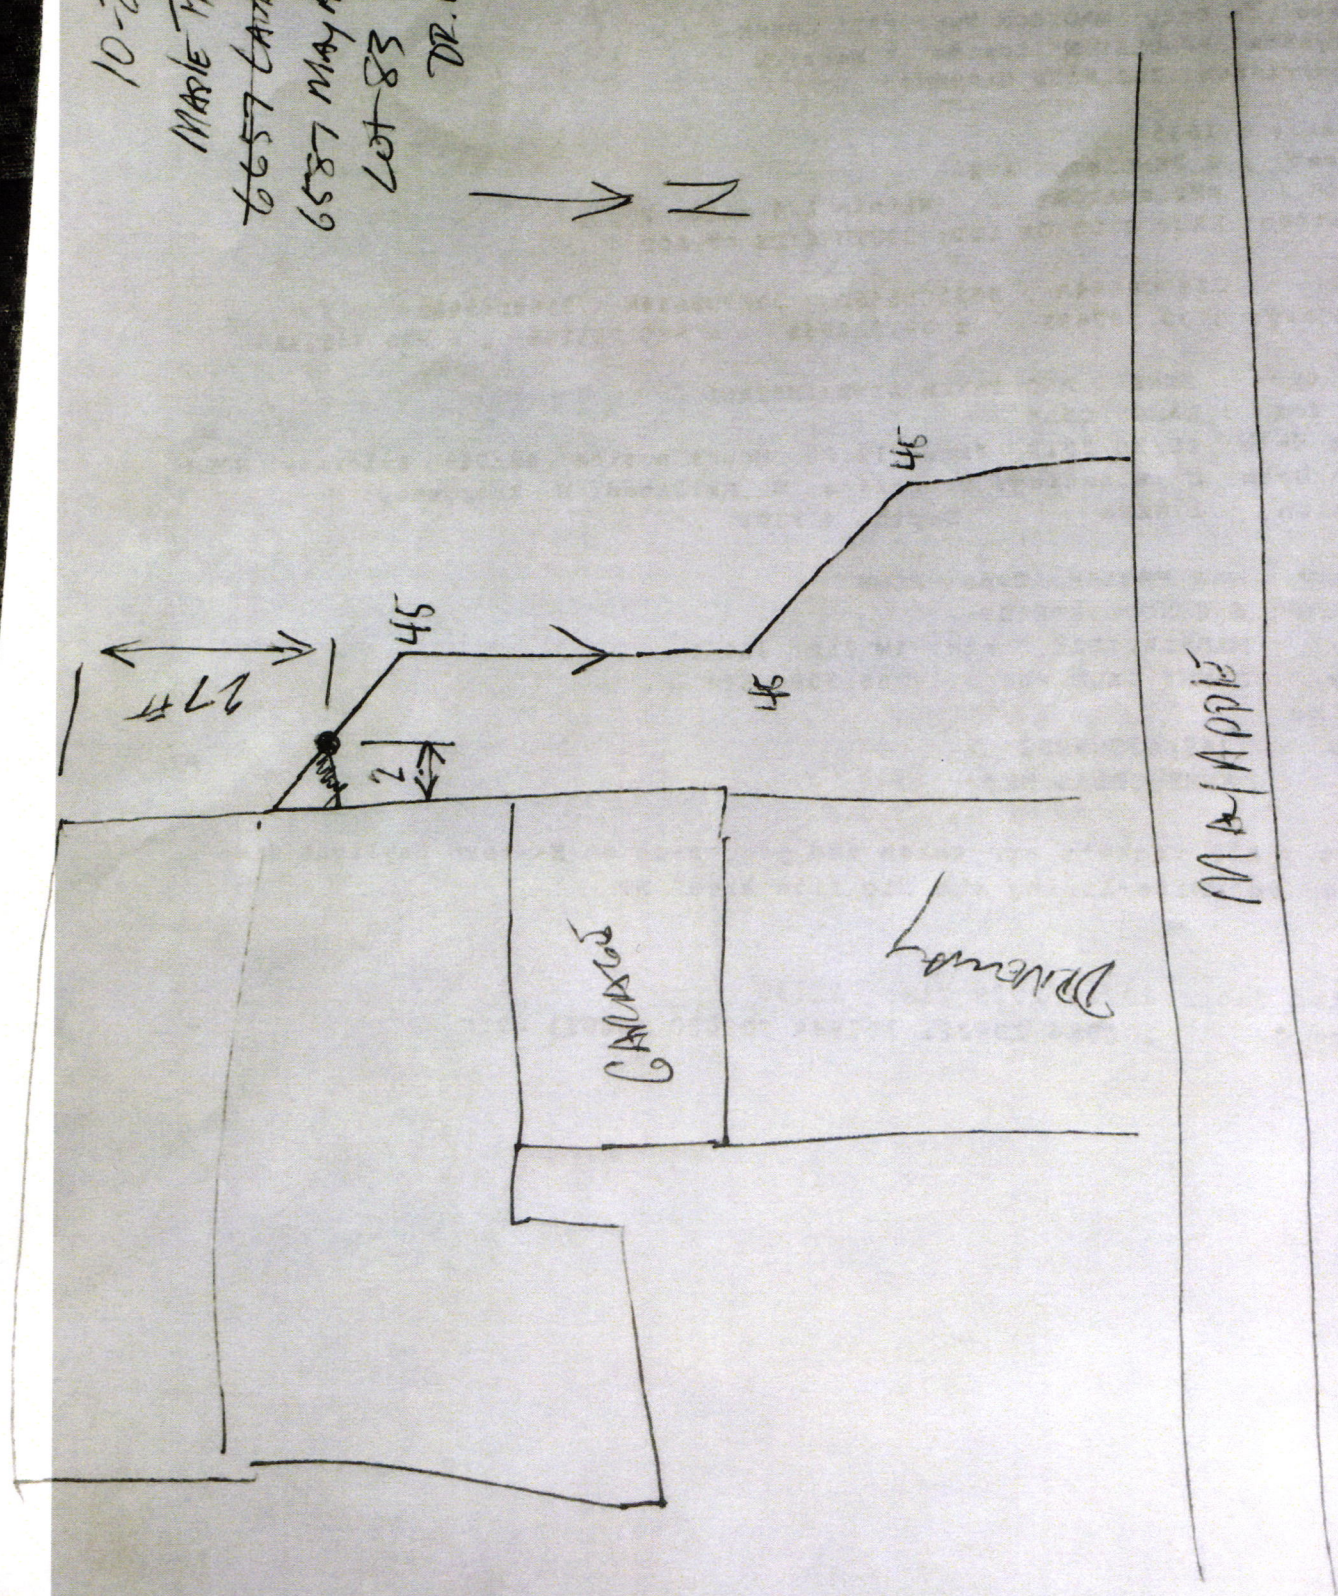



6587 Mayapple Dr Maple Trails Lot 83 Don Moore 10.29.19

