

#6782


This Agreement made and entered into this 18 day of Dec., 2018, between Fall Creek Regional Waste District ("District") and Arbor Homes ("Applicant") regarding the provision of sanitary sewer service, and the assignment of capacity in and connection to, the District's facilities for the premises located at Lot # 36

2 pictures attached





N  
↘

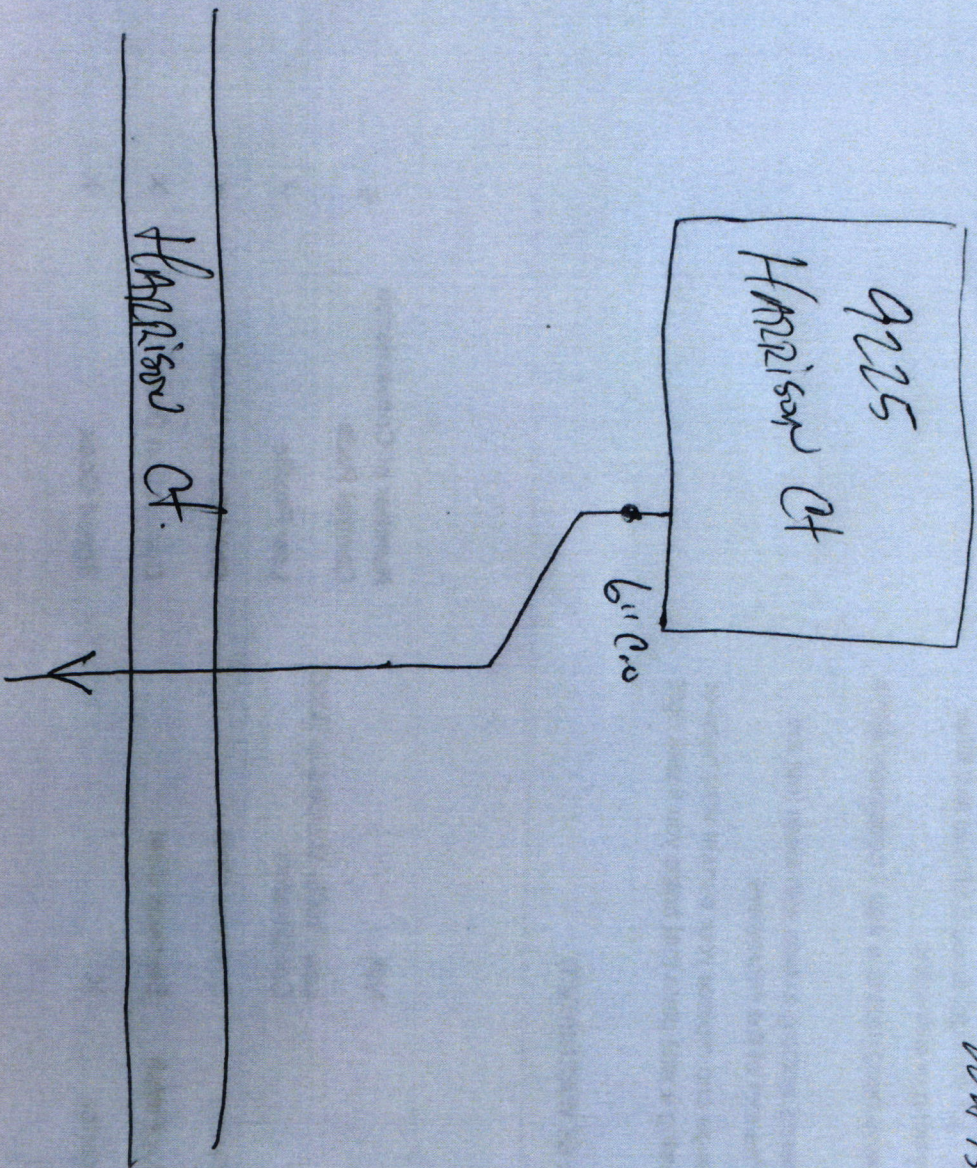

MAPLE TRAILS  
4-5-19  
LOT 36  
MARTIN EX.





L

36