8-12771.00


#7750


Fall Creek Regional Waste District

9378 S 650 W, P.O. Box 59, Pendleton, IN 46064 765-778-7544

Agreement for Sanitary Sewer Service

Regional Waste District ("District") and	day of March, 2020, between Fall Creek D.R. Horton/Westport Homes ("Applicant") regarding the ment of capacity in and connection to, the District's Lot 161
Street Address: Lola Blarn	ey DR, Perdleton
Now therefore, the parties, in consideration o receipt and sufficiency of which is hereby acknow	f the mutual promises set out in this Agreement, the ledged, agree as follows:
and the District's construction standards. I before backfilling and final connection is r	o and materials shall conform to all District ordinances District must accept and approve all work and materials made to the sewer mains. Any violation of this ances in violation to be removed and replaced at the
 The District shall have the right to enter up inspect, repair, or replace any equipment up has an impact on said service. 	oon the Applicant's premises at all reasonable times to used in connection with the District's service or which
failure to pay any rate charge or fee may re	monthly user rates, capacity charges, and tap fees. The esult in a lien against the property and/or the cost of which will be borne by Applicant, including, ollection costs.
4. The District shall not be responsible for any damages as a result of any failure to supply service unless said damages are due to default, neglect or culpability on the part of the District.	
property owner shall be required to connect	
concerns the property and the terms of this	orovision of sanitary sewer service touches and a Agreement bind the District and Applicant and their representatives, successors, agents, attorneys, assigns,
The parties hereto have read and fully understand the above provisions and agree to comply with said provisions.	
FALL CREEK REGIONAL WASTE DISTRICT	APPLICANT
Signature	Signature
STATE OF INDIANA)) SS:	
COUNTY OF MADISON) SUBSCRIBED and sworn to before me this _	day of , 20
My Commission Expires:	Signature
	Printed
	Notary Public Resident of County
************	Resident of County
Inspector Jan Date Inspected 13/11/23 Reason for Rejecton	
Date Reinspected	Approved Rejected
Notes: Size Pipe	
Basement Yes (No)	North
Sump Pump <u>Yes</u> No	U
Downspout to Ground Yes (No)	
Septic Tank Pumped & Filled <u>Yes No</u> Contractor () S E X C ,	
Special Conditions	Drawing
Existing Home	7
New Construction	T

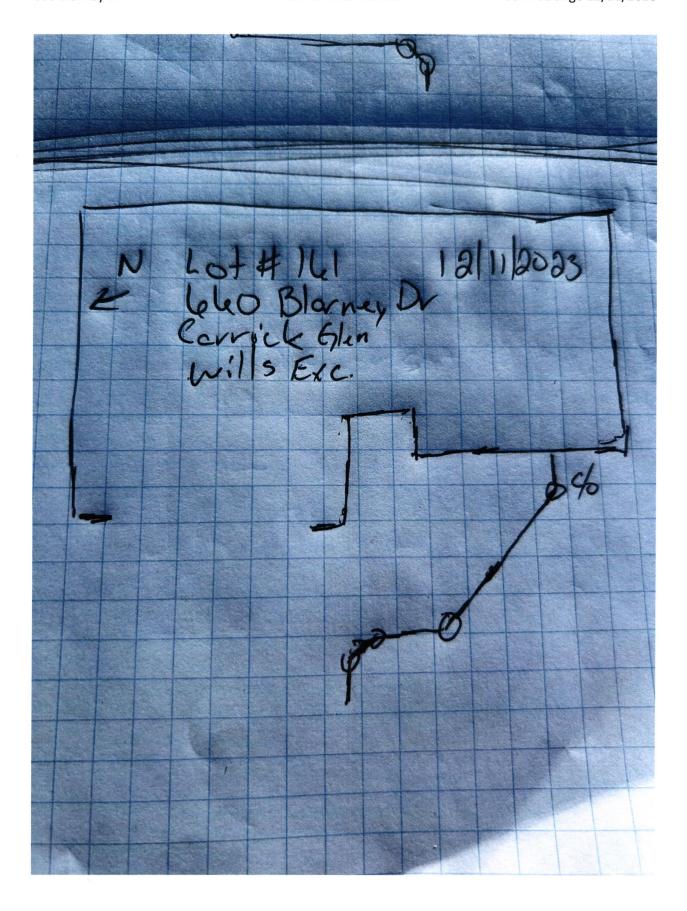

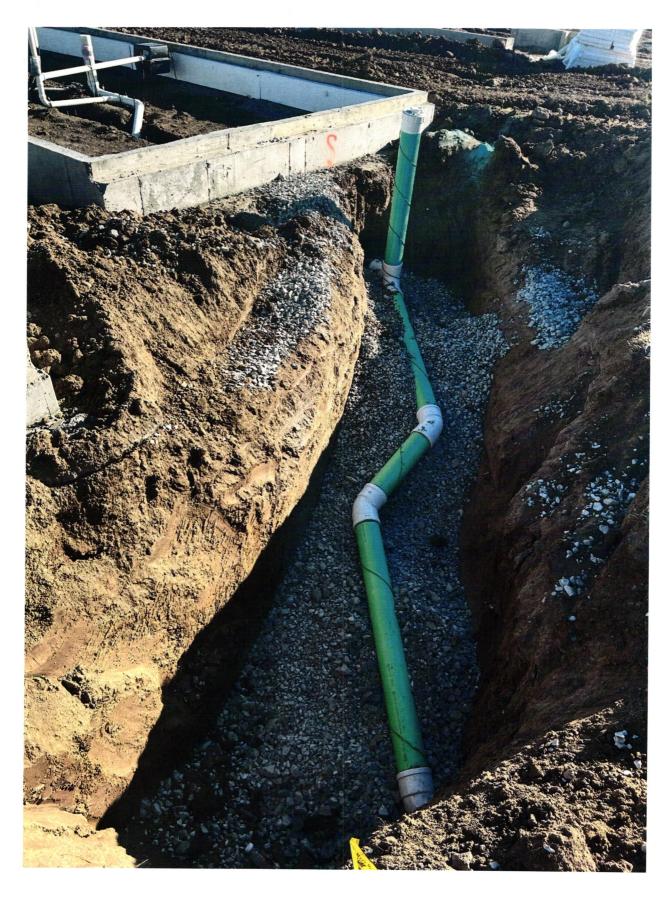

HECK IS PRINTED IN RED AND BLUE INK ON THE FACE ON CHEMICAL AND BLEACH REACTIVE PAPER WITH INVISIBLE FLUORESCENT FIBERS AND BASKETWEAVE ON BACK 1471004 **Check Number** S.R.HORTON' BHILDER

DRH Inc. Controlled Disb 1341 Horton Circle Arlington, TX 76011

JP Morgan Chase Bank, N.A. Syracuse, NY

50-937 213

Amount Date \$*****760.00 03/16/22

2720128

Void after 6 months from date of issue

SEVEN HUNDRED SIXTY AND 00/100 ****

Pay To The Order Of: FALL CREEK REGIONAL WASTE DISTRICT 9378 SOUTH 650 WEST PENDLETON IN 46064

D. L. Hocton