



# FALL CREEK REGIONAL WASTE DISTRICT

Box 44, Pendleton, Indiana 46064

3-0306030.01

Nº 001711

## APPLICATION FOR SEWER PERMIT

Permit No. \_\_\_\_\_ Date 1-19-90  
Permit Void 90 days from Date of Issuance  
Owner Name Pam Kepler  
Property Address 662 S Main St  
Lot # \_\_\_\_\_ P.O. Box \_\_\_\_\_  
Town Pendleton, IN Zip Code 46064  
Phone \_\_\_\_\_ Water Meter PEND.  
\$ 500.00 Tap on Fee Paid  
\$ 25.00 Inspection fee paid

Application is hereby made for connection to the Fall Creek Regional Waste District Sewer System for the above listed property - Permit Type: Residential X, Commercial \_\_\_\_\_, Industrial \_\_\_\_\_, or Governmental/Institutional \_\_\_\_\_. User Information \_\_\_\_\_.

All workmanship and materials shall conform to the standards of the District Ordinance as described in Ordinance 84-2 and 84-3 as amended. Acceptance and approval must be made by the District inspector or his duly authorized representative before backfilling and final connection is made to the main sewer lines. Any violation of applicable regulations will cause all lines and appurtenances in violation to be removed and replaced at the owners expense.

The Fall Creek Regional Waste District is responsible for the inspection, approval of materials, and installation techniques only. All costs for materials and installation and any liabilities resulting from same is the sole responsibility of the property owner.

I have read and fully understand the above provisions and agree to comply by said provisions.

X Pam Kepler  
APPLICANT(S) SIGNATURE

\*\*\*\*\*

INSPECTOR B

Date inspected 1-19-90 Approved ✓ Rejected \_\_\_\_\_

Reason for rejection \_\_\_\_\_

Date reinspected \_\_\_\_\_ Approved \_\_\_\_\_ Rejected \_\_\_\_\_

### Notes:

Size Pipe 6 "

Type Pipe PVC

Basement Yes \_\_\_\_\_ No ✓


Sump Pump Yes \_\_\_\_\_ No X

Downspout to Ground Yes X No \_\_\_\_\_

Septic Tank Pumped & filled Yes \_\_\_\_\_ No X

Contractor Dick Goley

Special Conditions New Const

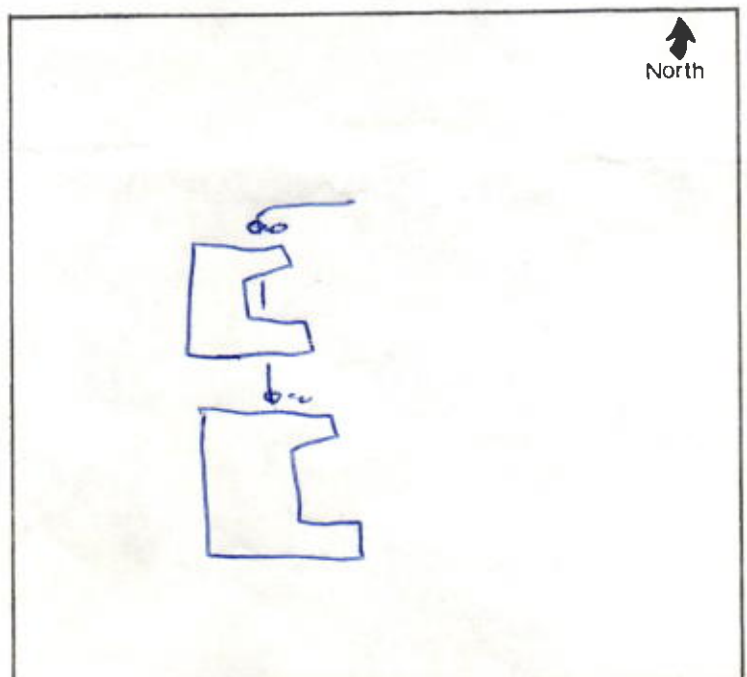

FALL CREEK REGIONAL WASTE DISTRICT

Box 24, Perinton, Indiana 46081



117100 2/

PERMIT TO CONSTRUCT

1-19-88

Permit No. 88-01

Permittee: Fall Creek Regional Waste District

Project: Sewer Main

Location: Perinton, Indiana

Sheet No. 1

Scale: 1" = 100'

THIS PERMIT IS GRANTED FOR THE CONSTRUCTION OF THE SEWER MAIN PROJECT DESCRIBED HEREIN. THE PERMITTEE SHALL BE RESPONSIBLE FOR OBTAINING ALL NECESSARY RIGHTS-OF-WAY AND EASEMENTS. THE PERMITTEE SHALL ALSO BE RESPONSIBLE FOR OBTAINING ALL NECESSARY APPROVALS FROM THE LOCAL GOVERNMENT AND THE STATE DEPARTMENT OF ENVIRONMENTAL MANAGEMENT.

THE PERMITTEE SHALL BE RESPONSIBLE FOR THE PROTECTION OF ALL EXISTING UTILITIES AND STRUCTURES. THE PERMITTEE SHALL ALSO BE RESPONSIBLE FOR THE PROTECTION OF ALL EXISTING TREES AND LANDSCAPE. THE PERMITTEE SHALL BE RESPONSIBLE FOR THE PROTECTION OF ALL EXISTING FISH AND WILDLIFE. THE PERMITTEE SHALL BE RESPONSIBLE FOR THE PROTECTION OF ALL EXISTING PLANTS AND ANIMALS.

THE PERMITTEE SHALL BE RESPONSIBLE FOR THE PROTECTION OF ALL EXISTING CULTURAL AND HISTORICAL RESOURCES. THE PERMITTEE SHALL BE RESPONSIBLE FOR THE PROTECTION OF ALL EXISTING MONUMENTS AND MEMORIALS. THE PERMITTEE SHALL BE RESPONSIBLE FOR THE PROTECTION OF ALL EXISTING LANDMARKS AND SCENIC VIEWSHIPS.

THE PERMITTEE SHALL BE RESPONSIBLE FOR THE PROTECTION OF ALL EXISTING OPEN SPACE AND RECREATION AREAS. THE PERMITTEE SHALL BE RESPONSIBLE FOR THE PROTECTION OF ALL EXISTING PARKS AND RECREATION AREAS. THE PERMITTEE SHALL BE RESPONSIBLE FOR THE PROTECTION OF ALL EXISTING TRAILS AND PATHS.

Permittee: Fall Creek Regional Waste District

Project: Sewer Main

Location: Perinton, Indiana

THIS PERMIT IS GRANTED FOR THE CONSTRUCTION OF THE SEWER MAIN PROJECT DESCRIBED HEREIN. THE PERMITTEE SHALL BE RESPONSIBLE FOR OBTAINING ALL NECESSARY RIGHTS-OF-WAY AND EASEMENTS. THE PERMITTEE SHALL ALSO BE RESPONSIBLE FOR OBTAINING ALL NECESSARY APPROVALS FROM THE LOCAL GOVERNMENT AND THE STATE DEPARTMENT OF ENVIRONMENTAL MANAGEMENT.



Permit No. 88-01  
Permittee: Fall Creek Regional Waste District  
Project: Sewer Main  
Location: Perinton, Indiana  
Sheet No. 1  
Scale: 1" = 100'