


N
↑

6-26-19
MAPLE TRAILS
LOT 31
DR. WILSON EX.

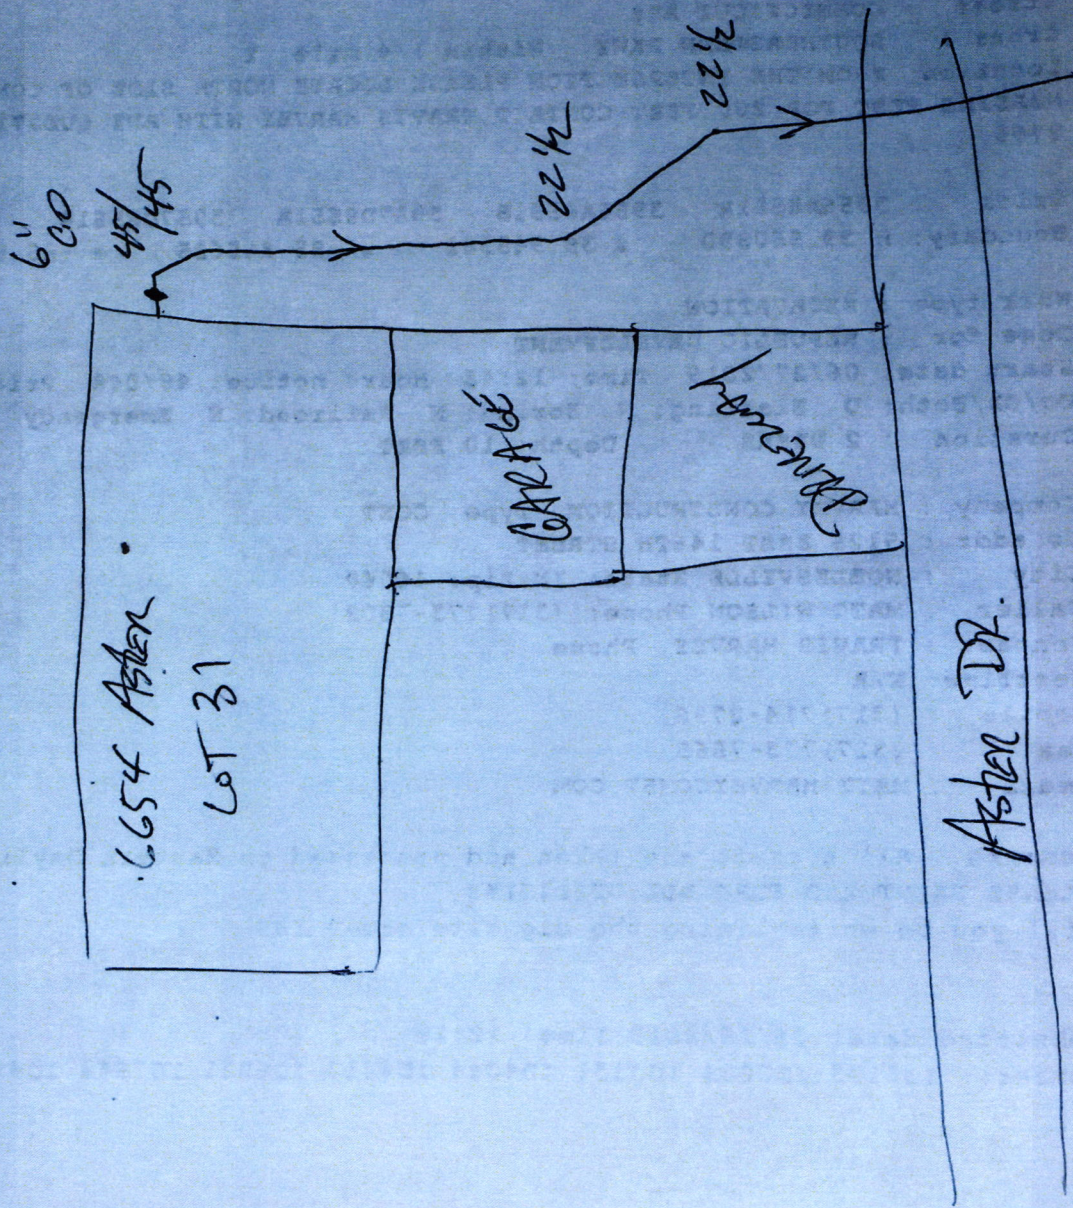

10054 Aster Dr

6.26.19

Don Moore

