

FALL CREEK REGIONAL WASTE DISTRICT

9378 S 650 WEST, P.O. BOX 59, PENDLETON, IN 46064

765-778-7544

AGREEMENT FOR SANITARY SEWER SERVICE

This Agreement made and entered into this 28 day of August, 2002, between FALL CREEK REGIONAL WASTE DISTRICT ("District") and Tom Walker ("Applicant") regarding the provision of sanitary sewer service, and the assignment of capacity in, and connection to, the District's facilities for the premises located at 6657 W. Fall Creek Dr

NOW THEREFORE, the parties, in consideration of the mutual promises set out in this Agreement, the receipt and sufficiency of which is hereby acknowledged, agree as follows:

1. The Applicant agrees that all workmanship and materials shall conform to all District ordinances and the District's construction standards. District must accept and approve all work and materials before backfilling and final connection is made to the sewer mains. Any violation of this provision will cause all lines and appurtenances in violation to be removed and replaced at the Applicant's expense.
2. The District shall have the right to enter upon the Applicant's premises at all reasonable times to inspect, repair, or replace any equipment used in connection with the District's service or which has an impact on said service.
3. The Applicant shall be responsible for all monthly user rates, capacity charges, and tap fees. The failure to pay any rate charge or fee may result in a lien against the property and/or the termination of service to the property, the cost of which will be borne by Applicant, including, but not limited to, all attorney's fees and collection costs.
4. The District shall not be responsible for any damages as a result of any failure to supply service unless said damages are due to default, neglect or culpability on the part of the District.
5. If there is an available sanitary sewer within three hundred (300) feet of the property line, the property owner shall be required to connect to the District's sanitary sewer system.
6. The Applicant and District agree that the provision of sanitary sewer service touches and concerns the property and the terms of this Agreement bind the District and Applicant and their heirs, executors, administrators, personal representatives, successors, agents, attorneys, assigns, designees, and transferees.

The parties hereto have read and fully understand the above provisions and agree to comply with said provisions.

FALL CREEK REGIONAL WASTE DISTRICT

Signature

APPLICANT

Signature

STATE OF INDIANA )  
 ) SS:  
COUNTY OF MADISON )

SUBSCRIBED and sworn to before me this 30<sup>th</sup> day of August, 2002.

My Commission Expires:

2-10-2008

Signature

Printed

Notary Public

Resident of Madison County

\*\*\*\*\*  
INSPECTOR Steve DATE INSPECTED 8/28/02 APPROVED ✓ REJECTED \_\_\_\_\_

REASON FOR REJECTION \_\_\_\_\_

DATE REINSPECTED \_\_\_\_\_ APPROVED \_\_\_\_\_ REJECTED \_\_\_\_\_

NOTES:

SIZE PIPE 4" 1/2 TYPE PIPE 3.5/160

BASEMENT YES NO

SUMP PUMP YES NO

DOWNSPOUT TO GROUND YES NO


SEPTIC TANK PUMPED & FILLED YES NO

CONTRACTOR home owner

SPECIAL CONDITIONS \_\_\_\_\_

EXISTING HOME ✓

NEW CONSTRUCTION \_\_\_\_\_

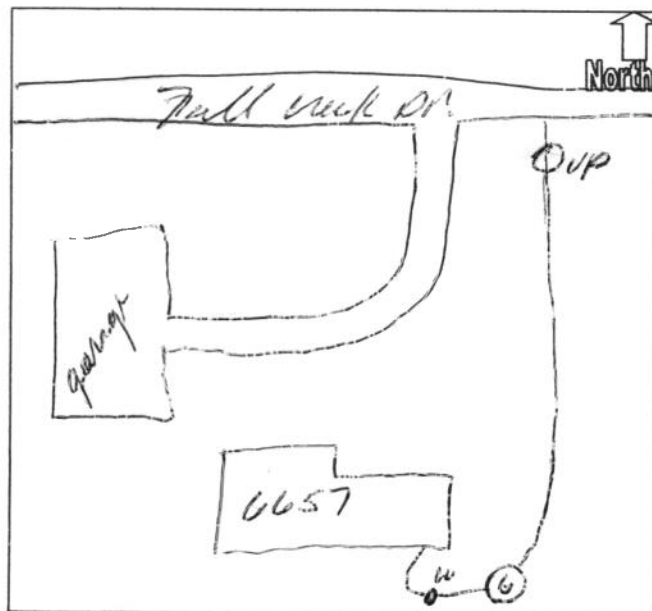

THOMAS WALKER  
JULIE E. WALKER  
6657 W. FALL CREEK DR.  
PENDLETON, IN 46064-9767

1002

DATE 9-3-02

6-103/410

PAY TO THE  
ORDER OF

Fall Creek Regional Waste \$ 3,659.00  
Three thousand Six hundred Fifty Nine & 00/100 DOLLARS

Security features  
are included.  
Details on back.



KeyBank National Association

1-800-KEY2YOU

KEO

FOR

Julie Walker

⑆041001039⑆96010101338789⑆1002

DATE	REFERENCE / INVOICE NO.	APV NUMBER	INVOICE AMOUNT	BALANCE
------	-------------------------	------------	----------------	---------


8/23/04

refund of connection fees & grinder  
per Grant Agreement

\$3659.00

Tap Fee	\$475.00
Capacity Fee	\$2160.00
Grinder	\$976.00
Tax	\$48.00

DETACH AND RETAIN FOR YOUR RECORDS

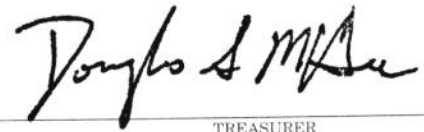THIS WARRANT VOID TWO (2) YEARS AFTER DEC. 31 OF THE YEAR OF ISSUE	FORM APPROVED BY STATE BOARD OF ACCOUNTS FOR FALL CREEK REGIONAL WASTE DISTRICT - 1988		019415	
	FALL CREEK REGIONAL WASTE DISTRICT PENDLETON, INDIANA 46064		71-553/749	
PAY TO THE ORDER OF	DATE	CHECK NUMBER	FUND	PAY EXACTLY
	8/23/04	19415	100	*\$3,659.00*
*Three Thousand Six Hundred Fifty Nine Dollars and 00/100**				
Tom Walker		 TREASURER		
MADISON COMMUNITY BANK PENDLETON, INDIANA				

⑈019415⑈ ⑆074905539⑆ 59⑈358? 3⑈

KOMPUTROL A/P VENDOR

BOYCE FORMS • SYSTEMS 1-800-382-8702 27044



## FALL CREEK REGIONAL WASTE DISTRICT

P.O. Box 59 • 9378 S. 650 West • Pendleton, Indiana 46064-0059 • (765) 778-7544

---

August 23, 2004

Mr. Tom Walker  
6657 W Fall Creek Drive  
Pendleton, IN 46064

Dear Mr. Walker:

Recently the Fall Creek Regional Waste District (FCRWD) was pleased to announce that a Community Focus Fund Grant has been awarded to the Town of Ingalls with FCRWD as a sub recipient by the Indiana Department of Commerce to fund construction of a wastewater collection system for the areas of Green Township known as County Roads 650 West, 750 West, 760 West, 900 South, 920 South, 800 West, 800 South, 875 South, Fall Creek Drive (between CR 650 W and CR 750 W), and Carefree Community Homes.

As Fall Creek Regional Waste District promised and as a result of the grant, residents in these areas will not be charged any connection fees and will be provided a residential wastewater grinder unit at no cost when they connect their homes to the sanitary system.

Enclosed please find a check in the amount of \$3,659.00 as reimbursement of your connection fees and the cost of your wastewater grinder unit.

Thank you for your support of our successful grant efforts.

Sincerely,

Teresa K. Hutton  
Office Manager