



# FALL CREEK REGIONAL WASTE DISTRICT

9378 S. 650 West PO Box 59  
Pendleton, IN 46064-0059 778-7544

26-00020.00

add order on file

## APPLICATION FOR SEWER PERMIT

Nº 2859

Date 8-3-2000

Permit Void 90 days from Date of Issuance

Owner Name Brian Zeigler

Property Address 6679 S 600 W

Lot # \_\_\_\_\_ P.O. Box \_\_\_\_\_

Town Pendleton, IN Zip Code 46064

Phone \_\_\_\_\_ City Water \_\_\_\_\_ Well ☒

\$ 2556.00 Tap on Fee Paid

\$ \_\_\_\_\_ Inspection fee paid

grinder unit paid for  
By Long + Kopper

Application is hereby made for connection to the Fall Creek Regional Waste District Sewer System for the above listed property - Permit Type: Residential ☒, Commercial \_\_\_\_\_, Industrial \_\_\_\_\_, or Governmental/Institutional \_\_\_\_\_. User Information \_\_\_\_\_.

All workmanship and materials shall conform to the standards of the District Ordinance as described in Ordinance 84-2 and 84-3 as amended. Acceptance and approval must be made by the District inspector or his duly authorized representative before backfilling and final connection is made to the main sewer lines. Any violation of applicable regulations will cause all lines and appurtenances in violation to be removed and replaced at the owners expense.

The Fall Creek Regional Waste District is responsible for the inspection, approval of materials, and installation techniques only. All costs for materials and installation and any liabilities resulting from same is the sole responsibility of the property owner.

I have read and fully understand the above provisions and agree to comply by said provisions.

Brian Zeigler  
APPLICANT(S) SIGNATURE

\*\*\*\*\*


INSPECTOR B

Date inspected 8-4-00 Approved ☒ Rejected \_\_\_\_\_

Reason for rejection \_\_\_\_\_

Date reinspected \_\_\_\_\_ Approved \_\_\_\_\_ Rejected \_\_\_\_\_

Notes: 4"  
Size Pipe \_\_\_\_\_  
Type Pipe PV  
Basement Yes \_\_\_\_\_ No ☒  
Sump Pump Yes \_\_\_\_\_ No ☒  
Downspout to Ground Yes ☒ No \_\_\_\_\_  
Septic Tank Pumped & filled Yes ☒ No \_\_\_\_\_  
Contractor Long + Kopper  
Special Conditions \_\_\_\_\_  
Existing Home ☒  
New Construction \_\_\_\_\_

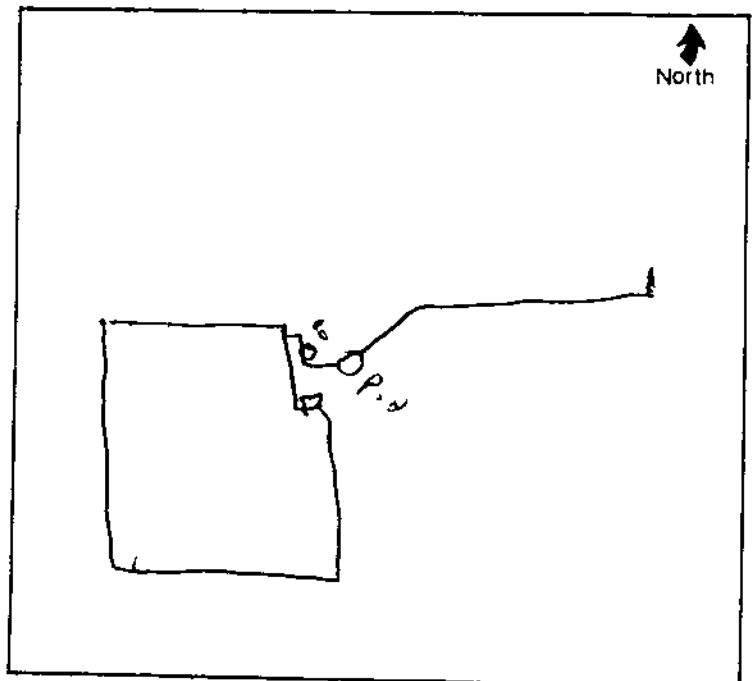

9378 S. CR 650 W.  
P.O. Box 59  
Pendleton, IN 46064  
Phone: 765-778-7544

**INVOICE**

Name Michael Scott *Brian Zeigler* Acct # 26-00020.00  
Address 6679 S 600 W  
City Pendleton State IN Zip 46064  
Phone \_\_\_\_\_

QTY	DESCRIPTION	UNIT PRICE	TOTAL
1	tap fee	\$400.00	\$400.00
1	capacity fee	\$2,156.00	\$2,156.00
		Sub-Total	\$2,556.00

<b>DATE</b>	<b>PAYMENT</b>	<b>CHECK NUMBER</b>	<b>AMOUNT</b>
		<b>Sub-Total</b>	<b>\$0.00</b>

***Detach bottom portion and return with payment***

**Cut here**

Name	Michael Scott	Acct #	26-00020.00
Address	6679 S 600 W		
City	Pendleton	State	IN Zip 46064
Phone			

Project Area # D  
W.O. # 9915  
Due Date 90 days

<b>Amount Due</b>	<b>\$2,556.00</b>
-------------------	-------------------

· DAILY · SUMMARY

CMD7-END

Account No 260002000 SCOTT, MICHAEL

6679 S 600 W

Sel	Date	Tran Type	Total	Waste Wtr	Penalty
	3/25/99	BILLING	27.35	27.35	
	4/26/99	BILLING	54.70	54.70	
	5/19/99	BILL ADJ	.41	.41	
	5/26/99	BILLING	82.05	82.05	
	6/25/99	BILLING	109.40	109.40	
	7/26/99	BILLING	136.75	136.75	
	8/27/99	BILLING	164.10	164.10	
	9/24/99	BILLING	191.45	191.45	
	10/25/99	BILLING	218.80	218.80	
	11/24/99	BILLING	246.15	246.15	
	12/23/99	BILLING	273.50	273.50	
	1/24/00	BILLING	300.85	300.85	
	2/17/00	BILL ADJ	4.10	4.10	
	2/25/00	BILLING	328.20	328.20	
	3/24/00	BILLING	355.55	355.55	

*Yd C Area 3 2-00*