



# FALL CREEK REGIONAL WASTE DISTRICT

9378 S. 650 West PO Box 59  
Pendleton, IN 46064-0059 778-7544

add order  
on file

21-03526.00

## APPLICATION FOR SEWER PERMIT

Nº 2878

Date 9-7-00

Permit Void 90 days from Date of Issuance

Owner Name Southgate Homes

Property Address 606 Inman Drive

Lot # \_\_\_\_\_ P.O. Box \_\_\_\_\_

Town Ingalls, IN Zip Code 46048

Phone \_\_\_\_\_ City Water ☒ Well ☐

\$ 700.00 Tap on Fee Paid

\$ \_\_\_\_\_ ~~Inspection fee paid~~

Application is hereby made for connection to the Fall Creek Regional Waste District Sewer System for the above listed property - Permit Type: Residential ☒, Commercial \_\_\_\_\_, Industrial \_\_\_\_\_, or Governmental/Institutional \_\_\_\_\_. User Information \_\_\_\_\_.

All workmanship and materials shall conform to the standards of the District Ordinance as described in Ordinance 84-2 and 84-3 as amended. Acceptance and approval must be made by the District inspector or his duly authorized representative before backfilling and final connection is made to the main sewer lines. Any violation of applicable regulations will cause all lines and appurtenances in violation to be removed and replaced at the owners expense.

The Fall Creek Regional Waste District is responsible for the inspection, approval of materials, and installation techniques only. All costs for materials and installation and any liabilities resulting from same is the sole responsibility of the property owner.

I have read and fully understand the above provisions and agree to comply by said provisions.

Jay McPherson

APPLICANT(S) SIGNATURE

\*\*\*\*\*

INSPECTOR Ben

Date inspected 11-28-00 Approved ☒ Rejected \_\_\_\_\_

Reason for rejection \_\_\_\_\_

Date reinspected \_\_\_\_\_ Approved \_\_\_\_\_ Rejected \_\_\_\_\_

Notes:

Size Pipe 6"

Type Pipe PVC

Basement Yes \_\_\_\_\_ No ☒

Sump Pump Yes \_\_\_\_\_ No ☒

Downspout to Ground Yes ☒ No \_\_\_\_\_


Septic Tank Pumped & filled Yes \_\_\_\_\_ No ☒

Contractor A+A

Special Conditions \_\_\_\_\_

Existing Home \_\_\_\_\_

New Construction ☒

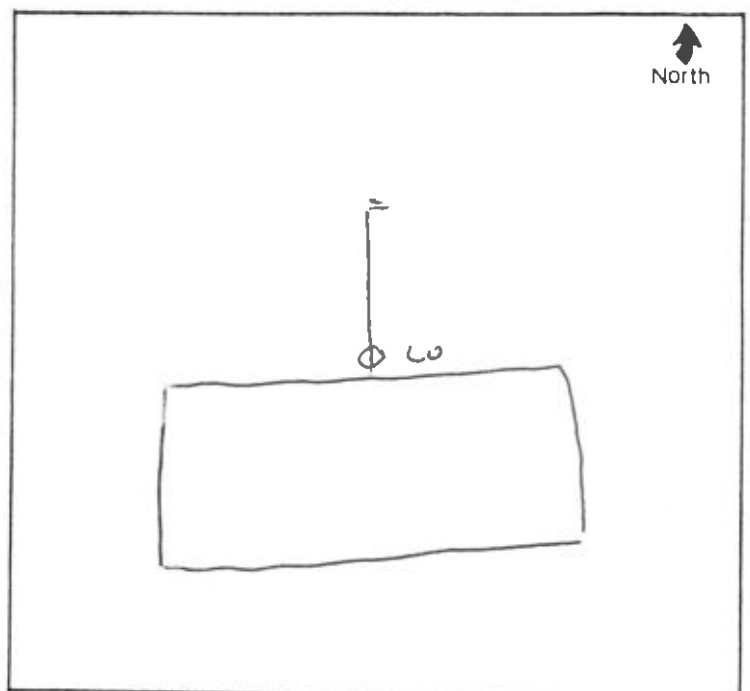

Handwritten notes at the top left corner.

Handwritten text, possibly a date or reference number.

Handwritten text in the upper middle section.

Handwritten text in the upper middle section.

Main body of handwritten text, appearing as several lines of notes.

Handwritten text in the lower middle section.

Handwritten text in the lower middle section.

