



FALL CREEK REGIONAL WASTE DISTRICT

9378 S. 650 West PO Box 59
Pendleton, IN 46064-0059 778-7544

APPLICATION FOR SEWER PERMIT

Nº 2603

Date 9-1-98

Permit Void 90 days from Date of Issuance

Owner Name Stephanie Owens (Charles Bolander)Property Address 6704 SR 67

Lot # _____ P.O. Box _____

Town Pendleton, IN Zip Code 46064

Phone _____ City Water _____ Well _____

\$ N/A Tap on Fee Paid\$ N/A Inspection fee paid

Application is hereby made for connection to the Fall Creek Regional Waste District Sewer System for the above listed property - Permit Type: Residential ☒, Commercial _____, Industrial _____, or Governmental/Institutional _____. User Information _____.

All workmanship and materials shall conform to the standards of the District Ordinance as described in Ordinance 84-2 and 84-3 as amended. Acceptance and approval must be made by the District inspector or his duly authorized representative before backfilling and final connection is made to the main sewer lines. Any violation of applicable regulations will cause all lines and appurtenances in violation to be removed and replaced at the owners expense.

The Fall Creek Regional Waste District is responsible for the inspection, approval of materials, and installation techniques only. All costs for materials and installation and any liabilities resulting from same is the sole responsibility of the property owner.

I have read and fully understand the above provisions and agree to comply by said provisions.

APPLICANT(S) SIGNATURE

INSPECTOR BDate inspected 9-1-98 Approved _____ Rejected _____

Reason for rejection _____

Date reinspected _____ Approved _____ Rejected _____


Notes:

Size Pipe 6"Type Pipe 24" 160Basement Yes _____ No ☒Sump Pump Yes _____ No ☒Downspout to Ground Yes ☒ No _____Septic Tank Pumped & filled Yes ☒ No _____Contractor Frederick

Special Conditions _____

Existing Home ☒

New Construction _____

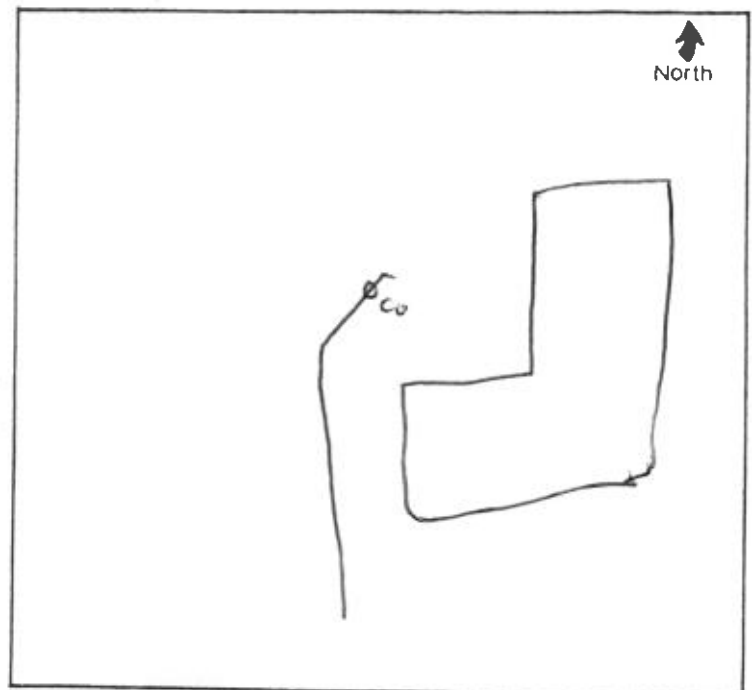

FALL CREEK REGIONAL WASTE DISTRICT

PO BOX 59
FALL CREEK, AR 72631-0059
726-1744



No 2503

APPLICATION FOR WASTE PERMIT

0-1-88

Date

Return Void 30 days from Date of Issuance

Owner Name St. Louis County (Municipal)

Property Address Box 59

City Fall Creek State AR Zip 72631

County Fall Creek District 1

Permit No. 2503

Inspector's Name W. J. [unclear]

Inspector's Title Inspector

Applicant's Name St. Louis County (Municipal)

Applicant's Title County Engineer

Applicant's Address Box 59, Fall Creek, AR 72631

Applicant's Phone 726-1744

Applicant's Fax 726-1744

Applicant's E-mail [unclear]

Applicant's Website [unclear]

Applicant's Project Description [unclear]

Applicant's Project Location [unclear]

Applicant's Project Status [unclear]

Applicant's Project Budget [unclear]

Applicant's Project Timeline [unclear]

Applicant's Project Risks [unclear]

Applicant's Project Benefits [unclear]

Applicant's Project Conclusion [unclear]

Applicant's Project Recommendation [unclear]

Applicant's Project Approval [unclear]

Applicant's Project Signature [unclear]

Applicant's Project Date [unclear]

Applicant's Project Title [unclear]

Applicant's Project Address [unclear]

Applicant's Project City [unclear]

Applicant's Project State [unclear]

Applicant's Project Zip [unclear]

Applicant's Project County [unclear]

Applicant's Project District [unclear]

Applicant's Project Permit No. [unclear]

Applicant's Project Inspector's Name [unclear]


Applicant's Project Inspector's Title [unclear]

Applicant's Project Inspector's Address [unclear]

Applicant's Project Inspector's City [unclear]

Applicant's Project Inspector's State [unclear]

Applicant's Project Inspector's Zip [unclear]

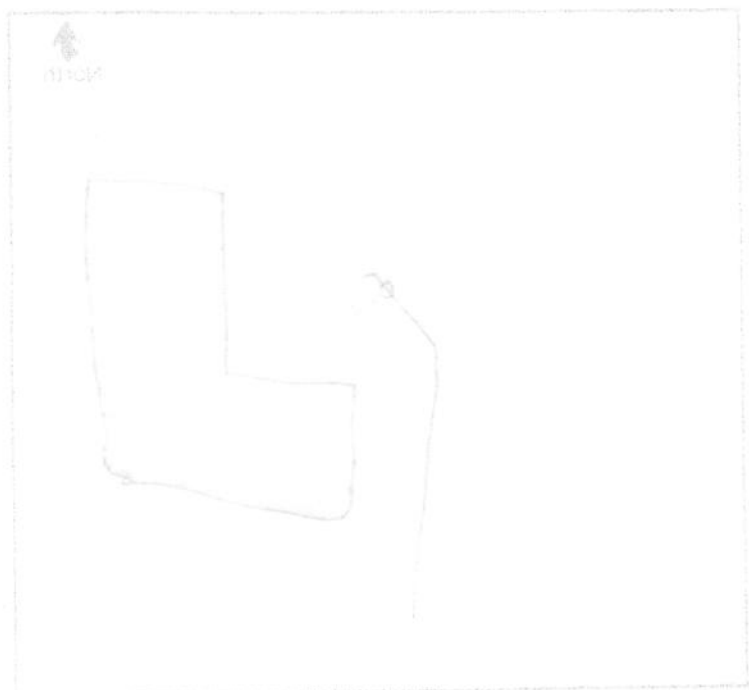

Project Name	St. Louis County (Municipal)
Project Address	Box 59, Fall Creek, AR 72631
Project City	Fall Creek
Project State	AR
Project Zip	72631
Project County	Fall Creek
Project District	1
Project Permit No.	2503
Project Inspector's Name	W. J. [unclear]
Project Inspector's Title	Inspector
Project Inspector's Address	[unclear]
Project Inspector's City	[unclear]
Project Inspector's State	[unclear]
Project Inspector's Zip	[unclear]