

FALL CREEK REGIONAL WASTE DISTRICT

9378 S 650 WEST, P.O. BOX 59, PENDLETON, IN 46064

765-778-7544

AGREEMENT FOR SANITARY SEWER SERVICE

No 6151

This Agreement made and entered into this 9th day of JANUARY, 200 7, between FALL CREEK REGIONAL WASTE DISTRICT ("District") and FRED GASKILL ("Applicant") regarding the provision of sanitary sewer service, and the assignment of capacity in, and connection to, the District's facilities for the premises located at 6706 S 50 W, Pendleton.

NOW THEREFORE, the parties, in consideration of the mutual promises set out in this Agreement, the receipt and sufficiency of which is hereby acknowledged, agree as follows:

1. The Applicant agrees that all workmanship and materials shall conform to all District ordinances and the District's construction standards. District must accept and approve all work and materials before backfilling and final connection is made to the sewer mains. Any violation of this provision will cause all lines and appurtenances in violation to be removed and replaced at the Applicant's expense.
2. The District shall have the right to enter upon the Applicant's premises at all reasonable times to inspect, repair, or replace any equipment used in connection with the District's service or which has an impact on said service.
3. The Applicant shall be responsible for all monthly user rates, capacity charges, and tap fees. The failure to pay any rate charge or fee may result in a lien against the property and/or the termination of service to the property, the cost of which will be borne by Applicant, including, but not limited to, all attorney's fees and collection costs.
4. The District shall not be responsible for any damages as a result of any failure to supply service unless said damages are due to default, neglect or culpability on the part of the District.
5. If there is an available sanitary sewer within three hundred (300) feet of the property line, the property owner shall be required to connect to the District's sanitary sewer system.
6. The Applicant and District agree that the provision of sanitary sewer service touches and concerns the property and the terms of this Agreement bind the District and Applicant and their heirs, executors, administrators, personal representatives, successors, agents, attorneys, assigns, designees, and transferees.

The parties hereto have read and fully understand the above provisions and agree to comply with said provisions.

FALL CREEK REGIONAL WASTE DISTRICT

Rebecca A. McClintick
Signature

APPLICANT

Fred Gaskill
Signature

STATE OF INDIANA)

) SS:

COUNTY OF MADISON)

SUBSCRIBED and sworn to before me this 9th day of JANUARY, 200 7.

My Commission Expires

5.19.07



Commission Expires

Rebecca A. McClintick
Signature

A Resident of

Madison County, Indiana

Rebecca A. McClintick, Notary Public
Resident of Madison County

INSPECTOR SN DATE INSPECTED 1-18-07 APPROVED _____ REJECTED _____

REASON FOR REJECTION _____

DATE REINSPECTED _____ APPROVED _____ REJECTED _____

NOTES:

SIZE PIPE 4" 12" TYPE PIPE 35/160 PSI

BASEMENT YES NO

SUMP PUMP YES NO

DOWNSPOUT TO GROUND YES NO


SEPTIC TANK PUMPED & FILLED YES NO

CONTRACTOR Danny Tesler

SPECIAL CONDITIONS Shirley Fredricks

EXISTING HOME ✓

NEW CONSTRUCTION _____

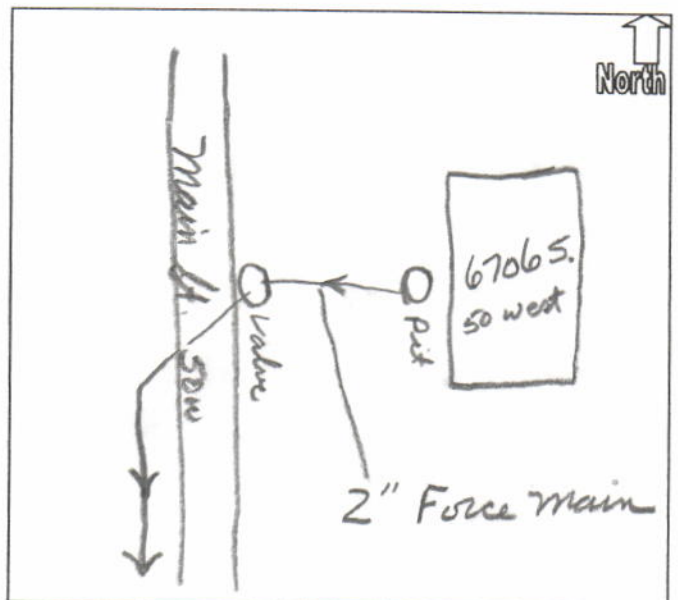

MainSource
BANK
GREENSBURG, INDIANA

OFFICIAL CHECK

HOLD DOCUMENT UP TO THE LIGHT TO VIEW TRUE WATERMARK
035986493

10-86
220

REMITTER Fred Gaskill

DATE Jan. 9, 2007

PAY
TO THE
ORDER

OF **Fall Creek Waste Management**

\$\$\$1,500.00**

MainSource 1,500dolls00cts

DOLLARS

DRAWEE: MainSource Bank

[Signature]

AUTHORIZED SIGNATURE

Issued by Integrated Payment Systems Inc., Englewood, Colorado
To Citibank, N.A., Buffalo, NY

⑈000495⑈ 1

GIVE
THANKS
to the LORD

FREDERICK K. GASKILL 3-89
JOYCE C. GASKILL
6766 S. 50 W. PH. 765-778-4796
BENDLETON, IN 46064

71-7258-2749

5178

Jan 9 2007

PAY Fall Creek Waste Management \$ 353.00
to the order of Three hundred fifty three & 00/100 DOLLARS

CAMPCO FEDERAL CREDIT UNION
5411 DR. MCK JR. BLVD.
ANDERSON, INDIANA 46013

for _____

Fredrick K. Gaskill

⑈274972582⑈

lap fee + grinder unit

of GOD
ETERNAL
FREDERICK K. GASKILL 3-89
JOYCE C. GASKILL
6766 S. 50 W. PH. 765-778-4796
PENDLETON, IN 46064

71-7258-2749

5203

Feb 1 2007

PAY *FCRWD* \$ 2160.00
to the order of *Two thousand one hundred sixty & 00/100* DOLLARS

LAMPCO FEDERAL CREDIT UNION
6011 DR. MLK JR. BLVD
ANDERSON, INDIANA 46013

for *Frederick K. Gaskill* MP

⑆ 27497258 2⑆