

FALL CREEK REGIONAL WASTE DISTRICT

9378 S 650 WEST, P.O. BOX 59, PENDLETON, IN 46064
765-778-7544

№ 5906

22-50/20.00

AGREEMENT FOR SANITARY SEWER SERVICE

This Agreement made and entered into this 22nd day of December, 2005, between FALL CREEK REGIONAL WASTE DISTRICT ("District") and Hallmark Homes ("Applicant") regarding the provision of sanitary sewer service, and the assignment of capacity in, and connection to, the District's facilities for the premises located at 111 10th St, Gray Squirrel Drive
East Knoll, 10th 24

NOW THEREFORE, the parties, in consideration of the mutual promises set out in this Agreement, the receipt and sufficiency of which is hereby acknowledged, agree as follows:

1. The Applicant agrees that all workmanship and materials shall conform to all District ordinances and the District's construction standards. District must accept and approve all work and materials before backfilling and final connection is made to the sewer mains. Any violation of this provision will cause all lines and appurtenances in violation to be removed and replaced at the Applicant's expense.
2. The District shall have the right to enter upon the Applicant's premises at all reasonable times to inspect, repair, or replace any equipment used in connection with the District's service or which has an impact on said service.
3. The Applicant shall be responsible for all monthly user rates, capacity charges, and tap fees. The failure to pay any rate charge or fee may result in a lien against the property and/or the termination of service to the property, the cost of which will be borne by Applicant, including, but not limited to, all attorney's fees and collection costs.
4. The District shall not be responsible for any damages as a result of any failure to supply service unless said damages are due to default, neglect or culpability on the part of the District.
5. If there is an available sanitary sewer within three hundred (300) feet of the property line, the property owner shall be required to connect to the District's sanitary sewer system.
6. The Applicant and District agree that the provision of sanitary sewer service touches and concerns the property and the terms of this Agreement bind the District and Applicant and their heirs, executors, administrators, personal representatives, successors, agents, attorneys, assigns, designees, and transferees.

The parties hereto have read and fully understand the above provisions and agree to comply with said provisions.

FALL CREEK REGIONAL WASTE DISTRICT
Deborah Wilson
Signature

APPLICANT
Hallmark Homes
Signature Wiley Wilson

STATE OF INDIANA)
) SS:
COUNTY OF MADISON)

SUBSCRIBED and sworn to before me this 22nd day of December, 2005.

My Commission Expires:
2-20-2008

Signature Deborah K. Wilson
Printed Deborah L. Wilson

Notary Public
Resident of Madison County

INSPECTOR SN DATE INSPECTED 9/7/06 APPROVED ✓ REJECTED _____

REASON FOR REJECTION _____

DATE REINSPECTED _____ APPROVED _____ REJECTED _____

NOTES:
SIZE PIPE 6" TYPE PIPE 35

BASEMENT YES _____ NO _____

SUMP PUMP YES _____ NO _____

DOWNSPOUT TO GROUND YES _____ NO _____


SEPTIC TANK PUMPED & FILLED YES _____ NO _____

CONTRACTOR Chambers EX.

SPECIAL CONDITIONS _____

EXISTING HOME _____

NEW CONSTRUCTION ✓

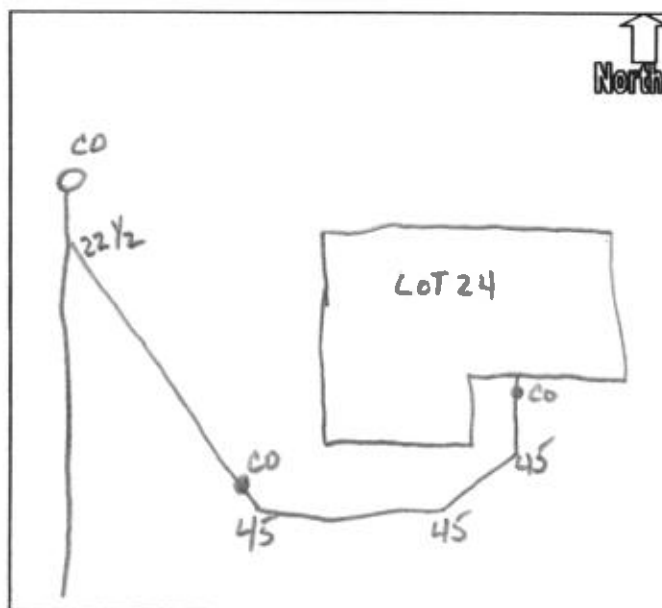

HALLMARK HOMES, INC.
433 E. 53RD STREET
ANDERSON, IN 46013
(765) 644-6566

STAR FINANCIAL BANK
INDIANAPOLIS, IN 46255
71-167749

85732

12/21/2005

PAY TO THE ORDER OF Fall Creek Regional Waste

\$ **2,635.00

Two Thousand Six Hundred Thirty-Five and 00/100*****

DOLLARS



Fall Creek Regional Waste

MP

MEMO

⑈085732⑈ ⑆074901672⑆

⑈11038097⑈

HALLMARK HOMES, INC.

85732

Fall Creek Regional Waste

12/21/2005

COST OF SALES:SITE IMPROVEMENTS:8020 Bergman sewer tap

2,635.00

Hallmark Homes Inc.- Star

2,635.00


© 2005 INTUIT INC. # 225 1-800-433-8810

FUGHES

Solutions. Supply. Service.

8-24-06

Fredricks
Const.

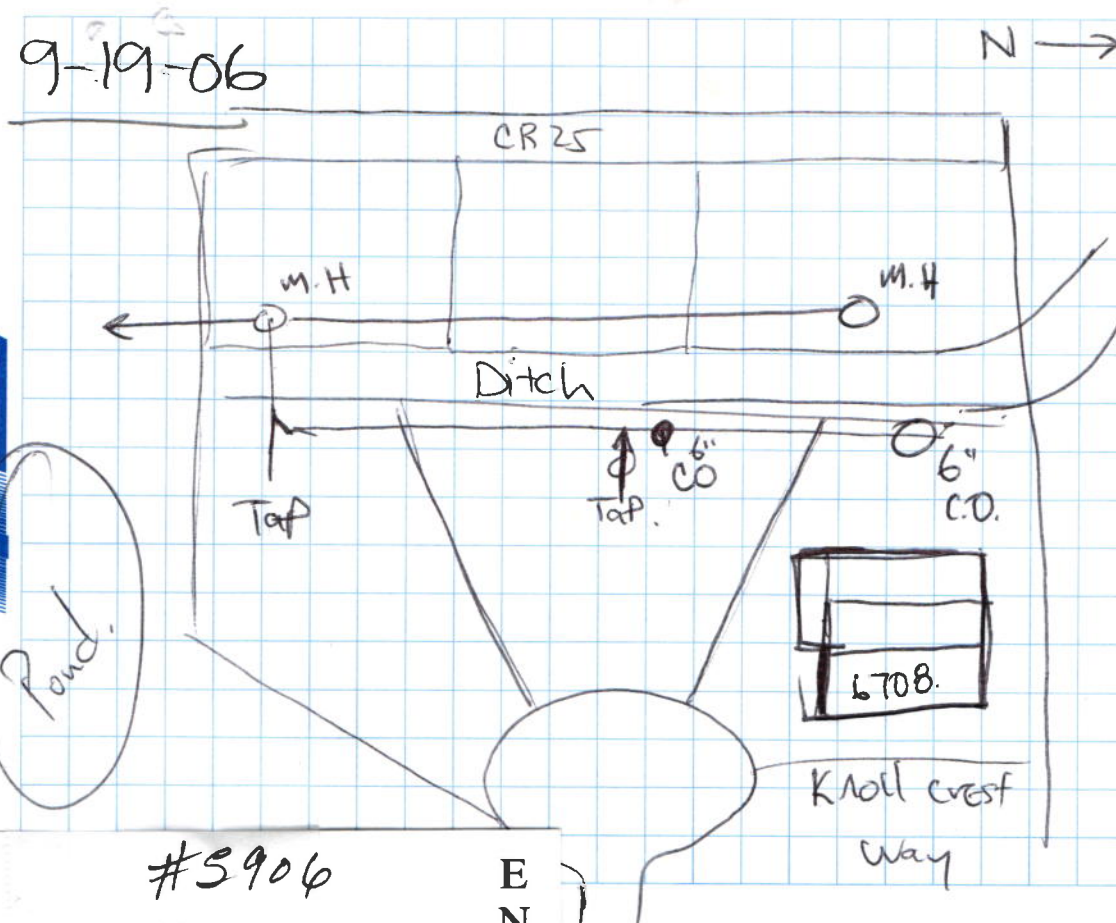

FT. WAYNE
(800) 873-2829
(219) 484-0739

INDIANAPOLIS
(800) 873-5895
(317) 545-6088

WHITESTOWN
(800) 361-4620
(317) 769-7011

FERNCO
Plumbing

#5906

East Knoll lot 24

6708 Knoll Crest Way

Rob + Rachel
Bergman lot 26
Oct. 20th

644-6566

E
N
G
I
N
E
E
R
I
N
G
•
A
R
C
H
I
T
E
C
T
U
R
E

TRIAD ASSOCIATES, INC.

5835 Lawton Loop East Drive

Indianapolis, Indiana 46216

Phone(317)377-5230 Fax(317)377-5241

"Serving Indiana cities and towns"