



FALL CREEK REGIONAL WASTE DISTRICT

9378 S. 650 West PO Box 59
Pendleton, IN 46064-0059 778-7544

add order
on file

22-50022.00

APPLICATION FOR SEWER PERMIT

Nº 2183

Date 3/27/95

Permit Void 90 days from Date of Issuance

Owner Name Bob Lamaster

Property Address 6712 S 25 East

Lot # 15 - East Knoll P.O. Box _____

Town Pendleton, IN Zip Code 46064

Phone _____ City Water _____ Well ☒

\$ 2700.00 Tap on Fee Paid

\$ 25.00 Inspection fee paid

Application is hereby made for connection to the Fall Creek Regional Waste District Sewer System for the above listed property - Permit Type: Residential ☒, Commercial _____, Industrial _____, or Governmental/Institutional _____. User Information _____.

All workmanship and materials shall conform to the standards of the District Ordinance as described in Ordinance 84-2 and 84-3 as amended. Acceptance and approval must be made by the District inspector or his duly authorized representative before backfilling and final connection is made to the main sewer lines. Any violation of applicable regulations will cause all lines and appurtenances in violation to be removed and replaced at the owners expense.

The Fall Creek Regional Waste District is responsible for the inspection, approval of materials, and installation techniques only. All costs for materials and installation and any liabilities resulting from same is the sole responsibility of the property owner.

I have read and fully understand the above provisions and agree to comply by said provisions.

APPLICANT(S) SIGNATURE

INSPECTOR llm

Date inspected 3-28-95 Approved _____ Rejected _____

Reason for rejection _____

Date reinspected _____ Approved _____ Rejected _____

Notes:

Size Pipe 6"

Type Pipe SDR 35

Basement Yes _____ No ☒

Sump Pump Yes _____ No _____

Downspout to Ground Yes ☒ No _____


Septic Tank Pumped & filled Yes _____ No _____

Contractor Blake

Special Conditions _____

Existing Home _____

New Construction ☒

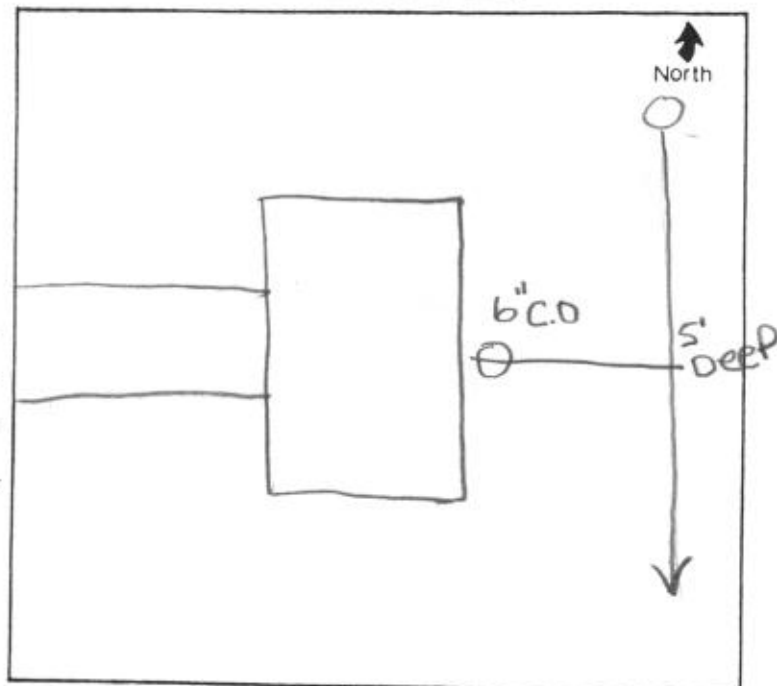

KOS

BLAKE HOMES
15 COTTAGE AVE.
P.O. BOX 136
MARKLEVILLE, IN 46056

NATIONAL CITY BANK
INDIANAPOLIS, IN 46255
20-6-740

11136

PAY *** TWO THOUSAND NINE HUNDRED TWENTY FIVE AND NO/100 DOLLARS ***

**TO THE
ORDER OF**

DATE
03/23/95

AMOUNT
\$\$\$2925.00**

Fall Creek Regional Waste
District
Box 44
Pendleton, IN 46064

Michael W. Blake

⑈011136⑈ ⑆074000065⑆ 300009099⑈

BLAKE HOMES

Voucher#	Invoice#	Date	Discount	Amount Paid	Description	11136
00005547		03/23/95	0.00	2925.00	sewer tap fee for lot 15	

Home owner

Bob Lamaster
6712 S. 25 E
Pendleton IN
46064

PLEASE ~~inspect~~ inspect
installation

East Knoll

FALLCREE Fall Creek Regional Waste

My Return Address is
324 Heath Street Way
Pendleton
46064

Total Amount Paid : 2925.00

Inspected 3-28-95
LM

March 31, 1995

Mr. Joe Blake
6569 W. 100 S.
New Palestine, IN 46163

RE: Check # 11136
East Knoll
Lot 15

Dear Mr. Blake:

We recently were in receipt of the above referenced check for \$2,925.00.

We are ready to refund the \$2,000 to you, but we are not sure why an extra \$200.00 was paid. If this is to be applied to something else, please let me know.

Sincerely,

Teresa Hutton
Office Manager

enc.

tkh