



# FALL CREEK REGIONAL WASTE DISTRICT

9378 S. 650 West PO Box 59  
Pendleton, IN 46064-0059 778-7544

26-00040.00

add order  
on file

## APPLICATION FOR SEWER PERMIT

Nº 2825

Date 6/28/00

Permit Void 90 days from Date of Issuance

Owner Name Brian Hensberger

Property Address 6715 S 600W

Lot # \_\_\_\_\_ P.O. Box \_\_\_\_\_

Town Pendleton, IN Zip Code 46064

Phone 778-7973 City Water \_\_\_\_\_ Well X

\$ 2556.00 Tap on Fee Paid grinder unit pd \$1024.80

\$ N/A Inspection fee paid

Application is hereby made for connection to the Fall Creek Regional Waste District Sewer System for the above listed property - Permit Type: Residential ☒, Commercial \_\_\_\_\_, Industrial \_\_\_\_\_, or Governmental/Institutional \_\_\_\_\_. User Information \_\_\_\_\_.

All workmanship and materials shall conform to the standards of the District Ordinance as described in Ordinance 84-2 and 84-3 as amended. Acceptance and approval must be made by the District inspector or his duly authorized representative before backfilling and final connection is made to the main sewer lines. Any violation of applicable regulations will cause all lines and appurtenances in violation to be removed and replaced at the owners expense.

The Fall Creek Regional Waste District is responsible for the inspection, approval of materials, and installation techniques only. All costs for materials and installation and any liabilities resulting from same is the sole responsibility of the property owner.

I have read and fully understand the above provisions and agree to comply by said provisions.

Brian Hensberger

APPLICANT(S) SIGNATURE

INSPECTOR TIM

Date inspected 7-14-00 Approved ☒ Rejected \_\_\_\_\_

Reason for rejection \_\_\_\_\_

Date reinspected \_\_\_\_\_ Approved \_\_\_\_\_ Rejected \_\_\_\_\_

### Notes:

Size Pipe 14"

Type Pipe 160

Basement Yes \_\_\_\_\_ No ☒

Sump Pump Yes \_\_\_\_\_ No ☒

Downspout to Ground Yes ☒ No \_\_\_\_\_


Septic Tank Pumped & filled Yes \_\_\_\_\_ No \_\_\_\_\_

Contractor TED's

Special Conditions \_\_\_\_\_

Existing Home ☒

New Construction \_\_\_\_\_

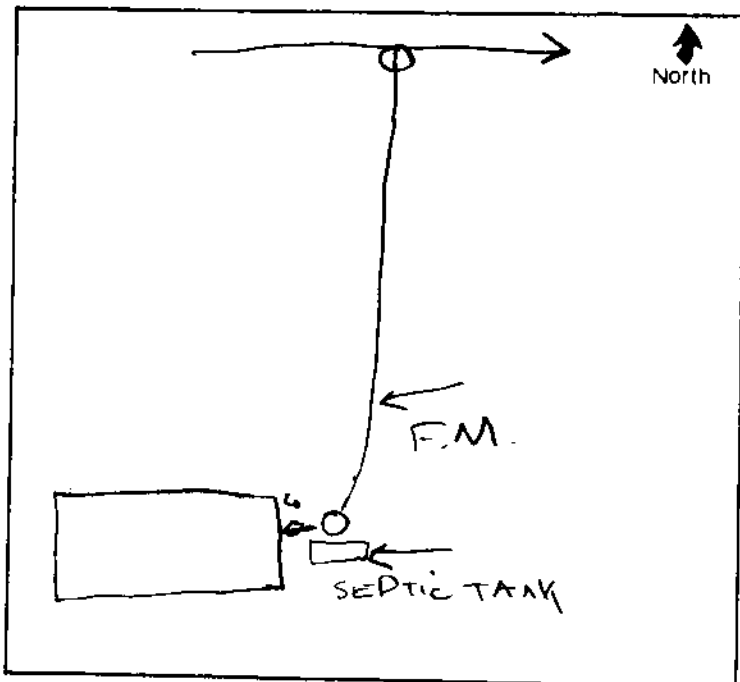




BRIAN L. HERSBERGER  
JULIA E. HERSBERGER  
6715 S 600 W  
Pendleton, In 46064

3687

20-6/740 305

Date 6/28/00

Pay to the Order of Small Creek Regional Waste \$ 3580.80

Three thousand five hundred eighty <sup>80</sup>/<sub>100</sub> Dollars  Security features included. Details on back.

**National City.**

National City Bank of Indiana  
Anderson, Indiana

For \_\_\_\_\_

Brian L. Hersberger MP

⑆071000065⑆

**Fax: 765-778-7545**

## Customer

Project Area # D  
W.O. # 9915  
Due Date 90 days

**Cut here**

## Customer

<b>Amount Due</b>	<b>\$2,556.00</b>
-------------------	-------------------

## DAILY SUMMARY

CMD7-END

Account No 260004000 HERSHBERGER, BRIAN 6715 S 600 W

Sel	Date	Tran Type	Total	Waste Wtr	Penalty
	3/25/99	BILLING	27.35	27.35	
	4/26/99	BILLING	54.70	54.70	
	5/19/99	BILL ADJ	.41	.41	
	5/26/99	BILLING	82.05	82.05	
	6/25/99	BILLING	109.40	109.40	
	7/26/99	BILLING	136.75	136.75	
	8/27/99	BILLING	164.10	164.10	
	9/24/99	BILLING	191.45	191.45	
	10/25/99	BILLING	218.80	218.80	
	11/24/99	BILLING	246.15	246.15	
	12/23/99	BILLING	273.50	273.50	
	1/24/00	BILLING	300.85	300.85	
	2/17/00	BILL ADJ	4.10	4.10	
	2/25/00	BILLING	328.20	328.20	
	3/24/00	BILLING	355.55	355.55	

pd 6