
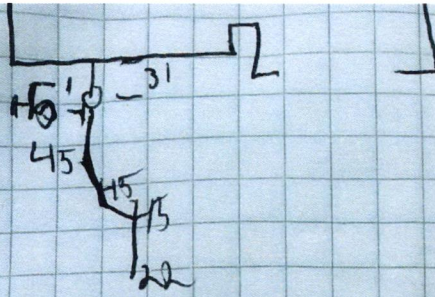


North 

Drawing
+
1 picture
attached



292 mapletrails, 6730 Blackthorne Lunar 9-19-22

