



FALL CREEK REGIONAL WASTE DISTRICT

9378 S. 650 West PO Box 59
Pendleton, IN 46064-0059 778-7544

22-50023.00

Nº 2277

APPLICATION FOR SEWER PERMIT

Date 9/28/95

Permit Void 90 days from Date of Issuance

Owner Name Keith Wooden

X Property Address 6736 S CR 25 E Pendleton IN 46056

Lot # 14-East Knoll P.O. Box

Town Pendleton, IN Zip Code 46064

Phone 643-5436 City Water Well X

\$ 2700.00 Tap on Fee Paid

\$ 25.00 Inspection fee paid 25.00 ultra inspection fee

Application is hereby made for connection to the Fall Creek Regional Waste District Sewer System for the above listed property - Permit Type: Residential X, Commercial, Industrial, or Governmental/Institutional. User Information

All workmanship and materials shall conform to the standards of the District Ordinance as described in Ordinance 84-2 and 84-3 as amended. Acceptance and approval must be made by the District inspector or his duly authorized representative before backfilling and final connection is made to the main sewer lines. Any violation of applicable regulations will cause all lines and appurtenances in violation to be removed and replaced at the owners expense.

The Fall Creek Regional Waste District is responsible for the inspection, approval of materials, and installation techniques only. All costs for materials and installation and any liabilities resulting from same is the sole responsibility of the property owner.

I have read and fully understand the above provisions and agree to comply by said provisions.

X 7L A Wood
APPLICANT(S) SIGNATURE

INSPECTOR

Date inspected Approved Rejected

Reason for rejection

Date reinspected Approved Rejected

Notes:

Size Pipe

Type Pipe

Basement Yes No

Sump Pump Yes No

Downspout to Ground Yes No


Septic Tank Pumped & filled Yes No

Contractor

Special Conditions

Existing Home

New Construction

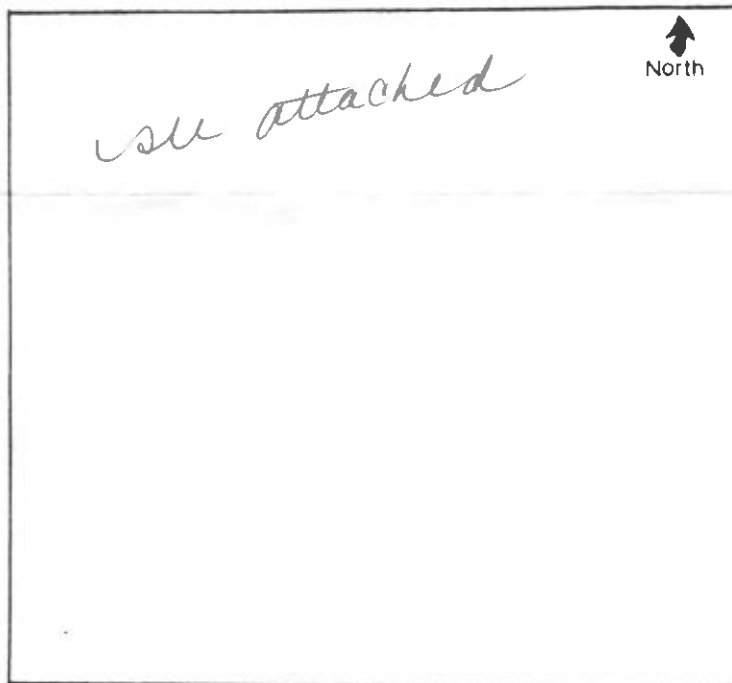

FALL CREEK REGIONAL WASTE DISTRICT

8375 E. 2ND WEST PO BOX 88
DANDENBURG IN 46004-0088



IN 8277

STATE OF INDIANA

WILLIAM

Form No. 1 (Type and Date of Inspection)

Waste District No. 2 CR 22 E Dandenburg IN 46004

Waste District Name: Dandenburg

Waste District No. 2 CR 22 E

Waste District Address: 8375 E. 2ND WEST

Waste District City: DANDENBURG

Waste District State: IN

Waste District Zip: 46004

Waste District Phone: (317) 460-0088

Waste District Fax: (317) 460-0088

Waste District E-mail: dandenburg@fallcreek.org

Waste District Website: www.fallcreek.org

Waste District Contact Person: [Name]

Waste District Contact Title: [Title]

Waste District Contact Address: [Address]

Waste District Contact City: [City]

Waste District Contact State: [State]

Waste District Contact Zip: [Zip]

Waste District Contact Phone: [Phone]

Waste District Contact Fax: [Fax]

Waste District Contact E-mail: [E-mail]

Waste District Contact Website: [Website]

Waste District Contact Person: [Name]

Waste District Contact Title: [Title]

Waste District Contact Address: [Address]

Waste District Contact City: [City]

Waste District Contact State: [State]

Waste District Contact Zip: [Zip]

Waste District Contact Phone: [Phone]

Waste District Contact Fax: [Fax]

Waste District Contact E-mail: [E-mail]

Waste District Contact Website: [Website]

Waste District Contact Person: [Name]

Waste District Contact Title: [Title]

Waste District Contact Address: [Address]

Waste District Contact City: [City]

Waste District Contact State: [State]

Waste District Contact Zip: [Zip]

Waste District Contact Phone: [Phone]



FALL CREEK REGIONAL WASTE DISTRICT

P.O. Box 59 • 9378 S. 650 West • Pendleton, Indiana 46064-0059 • (317) 778-7544

A G R E E M E N T

I, Keith Wooden, hereby agree to pay Fall Creek Regional Waste District a tap and inspection fee in the amount of, Two Thousand Seven Hundred Twenty-Five Dollars and No Cents (\$2,725.00) on or before January 15, 1996 for Lot 14 in East Knoll Subdivision, Pendleton, Indiana.

Keith Wooden
Signature

11-17-95
Date

STATE OF INDIANA)

COUNTY OF Madison)

SS: 313-64-6179

On this _____ day of _____, 1995, before the undersigned, a Notary Public in and for said County and State, personally appeared Mr. Keith Wooden, who acknowledges the execution of the above and foregoing Agreement to be his voluntary set act and deed.

WITNESS my hand and Notarial Seal this 18th day of November, 1995.

Aaron Lucas
Notary Public
Resident of Madison County

My Commission expires:

8-26-96



Info - Dessie

FALL CREEK REGIONAL WASTE DISTRICT

P.O. Box 59 • 9378 S. 650 West • Pendleton, Indiana 46064-0059 • (317) 778-7544

February 14, 1996


Mr. Keith Wooden
Warner Press
1200 E. 5th Street
Anderson, IN 46012

Dear Keith:

Just a reminder that we have not yet received the \$2,725 tap fee for your new home at 6736 S. CR 25 E., Pendleton, IN 46064.

Your prompt attention to this matter will be appreciated. If you are interested in our Time Payment Plan, please contact our Office Manager at 778-7544.

Sincerely,

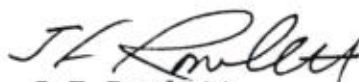
J.F. Rowlett
General Manager

JFR/tkh



FALL CREEK REGIONAL WASTE DISTRICT

9378 S. 650 West PO Box 59
Pendleton, IN 46064-0059 778-7544

APPLICATION FOR SEWER PERMIT

No 2277

Date 9/28/95

Permit Void 90 days from Date of Issuance

Owner Name Keith Wooden

X Property Address 6734 SCR 254

Lot # 14-East Knoll P.O. Box _____

Town Pendleton, IN Zip Code 46064

Phone _____ City Water _____ Well X

\$ _____ Tap on Fee Paid

\$ _____ Inspection fee paid

Application is hereby made for connection to the Fall Creek Regional Waste District Sewer System for the above listed property - Permit Type: Residential X, Commercial _____, Industrial _____, or Governmental/Institutional _____. User Information _____

All workmanship and materials shall conform to the standards of the District Ordinance as described in Ordinance 84-2 and 84-3 as amended. Acceptance and approval must be made by the District inspector or his duly authorized representative before backfilling and final connection is made to the main sewer lines. Any violation of applicable regulations will cause all lines and appurtenances in violation to be removed and replaced at the owners expense.

The Fall Creek Regional Waste District is responsible for the inspection, approval of materials, and installation techniques only. All costs for materials and installation and any liabilities resulting from same is the sole responsibility of the property owner.

I have read and fully understand the above provisions and agree to comply by said provisions.

X _____
APPLICANT(S) SIGNATURE

INSPECTOR B

Date inspected _____ Approved ✓ Rejected _____

Reason for rejection _____

Date reinspected _____ Approved _____ Rejected _____

Notes: _____

Size Pipe 6 " _____

Type Pipe PVC _____

Basement Yes _____ No X

Sump Pump Yes _____ No X

Downspout to Ground Yes X No _____


Septic Tank Pumped & filled Yes _____ No X

Contractor Ford

Special Conditions _____

Existing Home _____

New Construction U

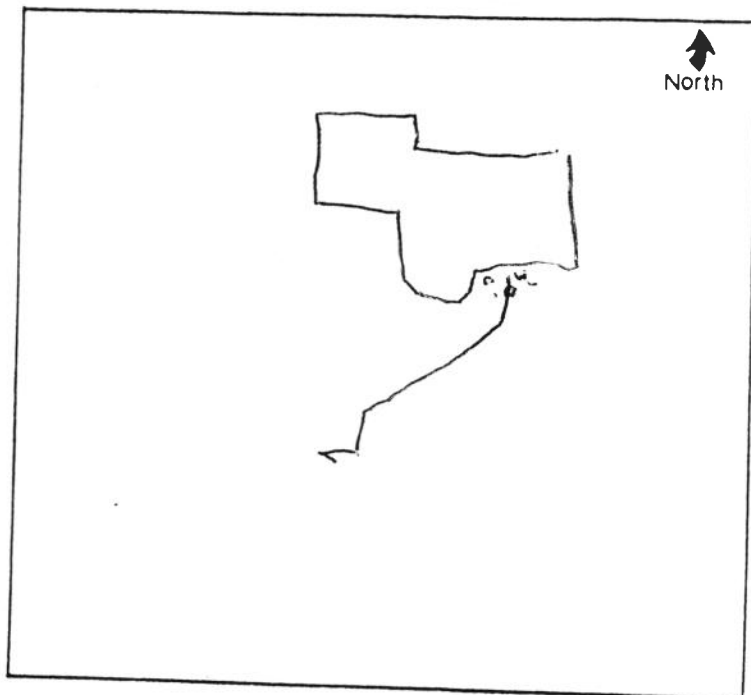



FALL CREEK REGIONAL WASTE DISTRICT

9378 S. 650 West PO Box 59
Pendleton, IN 46064-0059 778-7544

Nº 2277

APPLICATION FOR SEWER PERMIT

Date 9/28/95

Permit Void 90 days from Date of Issuance

Owner Name Keith Wooden

X Property Address _____

Lot # 14-East Knoll P.O. Box _____

Town Pendleton, IN Zip Code 46064

Phone _____ City Water _____ Well X

\$ _____ Tap on Fee Paid

\$ _____ Inspection fee paid

Application is hereby made for connection to the Fall Creek Regional Waste District Sewer System for the above listed property - Permit Type: Residential X, Commercial _____, Industrial _____, or Governmental/Institutional _____. User Information _____.

All workmanship and materials shall conform to the standards of the District Ordinance as described in Ordinance 84-2 and 84-3 as amended. Acceptance and approval must be made by the District inspector or his duly authorized representative before backfilling and final connection is made to the main sewer lines. Any violation of applicable regulations will cause all lines and appurtenances in violation to be removed and replaced at the owners expense.

The Fall Creek Regional Waste District is responsible for the inspection, approval of materials, and installation techniques only. All costs for materials and installation and any liabilities resulting from same is the sole responsibility of the property owner.

I have read and fully understand the above provisions and agree to comply by said provisions.

X _____
APPLICANT(S) SIGNATURE

INSPECTOR [Signature]

Date inspected _____ Approved ✓ Rejected _____

Reason for rejection _____

Date reinspected _____ Approved _____ Rejected _____

Notes:

Size Pipe 6"

Type Pipe PVC

Basement Yes _____ No X

Sump Pump Yes _____ No X

Downspout to Ground Yes X No _____


Septic Tank Pumped & filled Yes _____ No X

Contractor Ford

Special Conditions _____

Existing Home _____

New Construction U

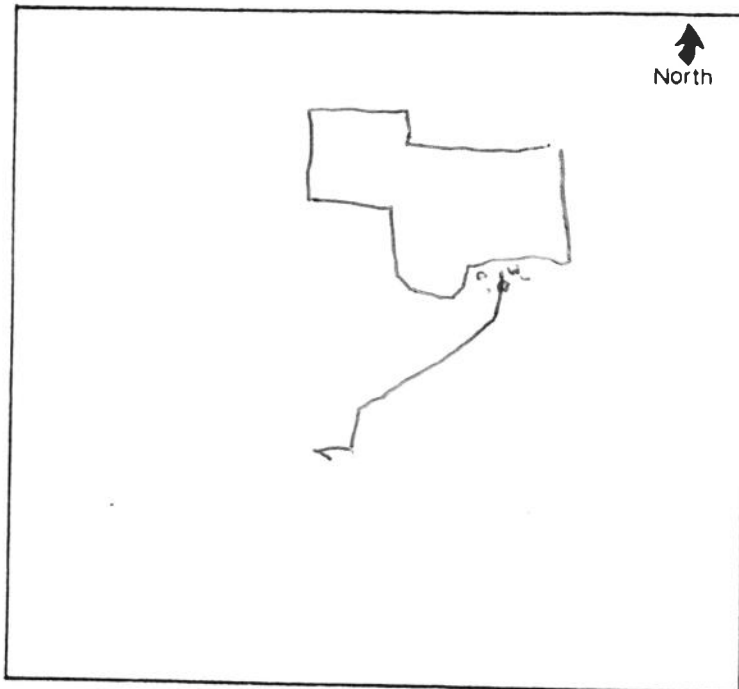



FALL CREEK REGIONAL WASTE DISTRICT

P.O. Box 59 • 9378 S. 650 West • Pendleton, Indiana 46064-0059 • (317) 778-7544

A G R E E M E N T

I, Keith Wooden, hereby agree to pay Fall Creek Regional Waste District a tap and inspection fee in the amount of, Two Thousand Seven Hundred Twenty-Five Dollars and No Cents (\$2,725.00) on or before January 15, 1996 for Lot 14 in East Knoll Subdivision, Pendleton, Indiana.

Signature

Date

STATE OF INDIANA)

COUNTY OF _____)

SS:

On this _____ day of _____, 1995, before the undersigned, a Notary Public in and for said County and State, personally appeared Mr. Keith Wooden, who acknowledges the execution of the above and foregoing Agreement to be his voluntary set act and deed.

WITNESS my hand and Notarial Seal this _____ day of _____, 1995.

Notary Public

Resident of _____ County

My Commission expires:



FALL CREEK REGIONAL WASTE DISTRICT

P.O. Box 59 • 9378 S. 650 West • Pendleton, Indiana 46064-0059 • (317) 778-7544

February 14, 1996

Mr. Keith Wooden
Warner Press
1200 E. 5th Street
Anderson, IN 46012

Dear Keith:

Just a reminder that we have not yet received the \$2,725 tap fee for your new home at 6736 S. CR 25 E., Pendleton, IN 46064.

Your prompt attention to this matter will be appreciated. If you are interested in our Time Payment Plan, please contact our Office Manager at 778-7544.

Sincerely,

J.F. Rowlett
J.F. Rowlett
General Manager

JFR/tkh

- See -

Jan. 15th

*725
2 yr 18%*